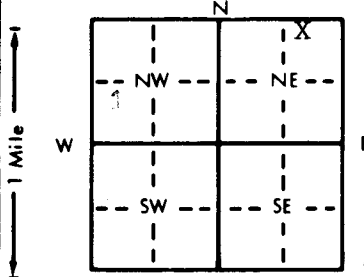


1 LOCATION OF WATER WELL: County: <u>Pratt</u> NE	Fraction NE 1/4 NW 1/4 NE 1/4	Section Number 21	Township Number T 28 S	Range Number R 12W E/W
--	----------------------------------	----------------------	---------------------------	---------------------------

Distance and direction from nearest town or city street address of well if located within city?

3 Miles South 5/8 East Of Pratt, Kans.

2 WATER WELL OWNER: RR#, St. Address, Box # : City, State, ZIP Code	Darell Brehm 425 Southeast 70th St. Pratt kans. 67124	Board of Agriculture, Division of Water Resources Application Number: 44664
---	---	--

3 LOCATE WELL'S LOCATION WITH AN "X" IN SECTION BOX: 	4 DEPTH OF COMPLETED WELL: 156 ft. ELEVATION: Depth(s) Groundwater Encountered 1. 80 ft. 2. ft. 3. ft. WELL'S STATIC WATER LEVEL 62 ft. below land surface measured on mo/day/yr AAUGUST 15-20 Pump test data: Well water was ft. after hours pumping gpm Est. Yield Na gpm: Well water was ft. after hours pumping gpm Bore Hole Diameter 8 in. to 156 in. to ft. and in. to ft. WELL WATER TO BE USED AS: 1 Domestic 3 Feedlot 6 Oil field water supply 9 Dewatering 12 Other (Specify below) 2 Irrigation 4 Industrial 7 Lawn and garden only 10 Monitoring well Was a chemical/bacteriological sample submitted to Department? Yes No XX; If yes, mo/day/yr sample was submitted Water Well Disinfected? Yes No XX
--	--

5 TYPE OF BLANK CASING USED: 1 Steel 3 RMP (SR) 2 PVC XX 4 ABS Blank casing diameter 16 in. to 96 ft. Dia. in. to ft. Dia. in. to ft. Casing height above land surface 14 in. weight 15.92 lbs./ft. Wall thickness or gauge No. 49 TYPE OF SCREEN OR PERFORATION MATERIAL: 1 Steel 3 Stainless steel 5 Fiberglass 7 PVC XX 10 Asbestos-cement 2 Brass 4 Galvanized steel 6 Concrete tile 8 RMP (SR) 11 Other (specify) 12 None used (open hole) SCREEN OR PERFORATION OPENINGS ARE: 1 Continuous slot 3 Mill slot XX 5 Gauzed wrapped 8 Saw cut 11 None (open hole) 2 Louvered shutter 4 Key punched 6 Wire wrapped 9 Drilled holes 7 Torch cut 10 Other (specify) SCREEN-PERFORATED INTERVALS: From 156 ft. to 96 ft. From ft. to ft. GRAVEL PACK INTERVALS: From ft. to ft. From ft. to ft. From 156 ft. to 23 ft. From ft. to ft.

6 GROUT MATERIAL: 1 Neat cement XX 2 Cement grout 3 Bentonite 4 Other Grout Intervals: From 23 ft. to 0 ft. From ft. to ft. From ft. to ft. What is the nearest source of possible contamination: 1 Septic tank 4 Lateral lines 7 Pit privy 10 Livestock pens 14 Abandoned water well 2 Sewer lines 5 Cess pool 8 Sewage lagoon 11 Fuel storage 15 Oil well/Gas well 3 Water right sewer lines 6 Seepage pit 9 Feedyard 12 Fertilizer storage 16 Other (specify below) 13 Insecticide storage Direction from well? S.W. How many feet? APP: 2640'

FROM	TO	LITHOLOGIC LOG	FROM	TO	PLUGGING INTERVALS
0'	2'	Top Soil	132'	150'	Medium Course Sand.
2'	16'	Hard Clay W/ Clatche.	150'	156'	Brown Clay.
16'	19'	Course Sand & Gravel.			
19'	26'	Brown Clay.			
26'	37'	Medium Course Sand W/ Clay Strips.			
37'	51'	Brown Clay /Clatche Strips.			
51'	68'	Medium Fine Sand.			
68'	79'	Brown Clay.			
79'	85'	Medium Course Sand.			
85'	96'	Course Sand & Gravel.			
96'	105'	Fine Sand.			
105'	109'	Course Sand & Gravel.			
109'	112'	Clay.			
112'	118'	Medium Course Sand.			
118'	132'	Medium Fine sand.			

7 CONTRACTOR'S OR LANDOWNER'S CERTIFICATION: This water well was (1) constructed, (2) reconstructed, or (3) plugged under my jurisdiction and was completed on (mo/day/year) July 30 2002 and this record is true to the best of my knowledge and belief. Kansas Water Well Contractor's License No. 112 This Water Well Record was completed on (mo/day/yr) August 20 2002 under the business name of Wells Drilling Co. by (signature) Dal Wells
--