


1 LOCATION OF WATER WELL:	Fraction	Section Number	Township Number	Range Number
County: PRATT	NW 1/4 NW 1/4 NW 1/4	23	28 S	12 W

Distance and direction from nearest town or city street address of well if located within city?

SOUTH EAST CORNER OF 70th AVE AND 30th AVE 300yds EAST side2 WATER WELL OWNER: **MIKE FAIRLEIGH**RR#, St. Address, Box #: **30028 S.E. 70th AVE** Board of Agriculture, Division of Water Resources
City, State, ZIP Code: **PRATT KS 67124** Application Number:

3 MARK WELL'S LOCATION WITH AN "X" IN SECTION BOX:

N

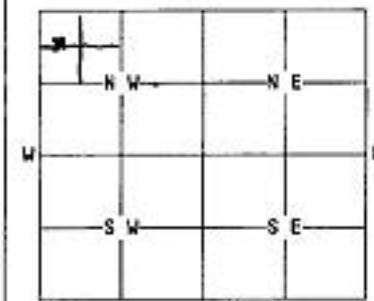

S

4 DEPTH OF WELL: **115** ft.WELL'S STATIC WATER LEVEL: **85** ft.

WELL WAS USED AS:

- ☒ 1 Domestic
☐ 2 Irrigation
☐ 3 Feedlot
☐ 4 Industrial

- ☐ 5 Public Water Supply
☐ 6 Oil Field Water Supply
☐ 7 Lawn and Garden Only
☐ 8 Air Conditioning

- ☐ 9 Dewatering
☐ 10 Monitoring Well
☐ 11 Injection Well
☐ 12 Other

Was a chemical/bacteriological sample submitted to Department? Yes ☒ No ☐
If yes, mo/day/yr sample was submitted:Water Well Disinfected: Yes ☒ No ☐

5 TYPE OF BLANK CASING USED:

- ☒ 1 Steel 3 RMP (SR) 5 Wrought 7 Fiberglass 9 Other (specify below)
☐ 2 PVC 4 ABS 6 Asbestos-Cement 8 Concrete Tile

Blank casing diameter: **5** in. Was casing pulled? Yes ☐ No ☒ If yes, how much:
Casing height above or below land surface: **60** in.6 GROUT PLUG MATERIAL: 1 Neat cement 2 Cement grout ☒ 3 Bentonite 4 Other:Grout Plug Intervals: From **115** ft. to **5** ft., From ft. to ft., From to ft.

What is the nearest source of possible contamination:

- | | | | |
|--------------------------|-------------------|-------------------------|--|
| 1 Septic tank | 6 Seepage pit | 11 Fuel storage | ☒ 16 Other (specify below) |
| 2 Sewer lines | 7 Pit privy | 12 Fertilizer storage | |
| 3 Watertight sewer lines | 8 Sewage lagoon | 13 Insecticide storage | CROP LAND |
| 4 Lateral lines | 9 Feedyard | 14 Abandoned water well | |
| 5 Cess Pool | 10 Livestock pens | 15 Oil well/Gas well | |

Direction from well? **EAST & South** How many feet? **12**

FROM	TO	PLUGGING MATERIALS
115'	5'	Bentonite Chips

7 CONTRACTOR'S OR LANDOWNER'S CERTIFICATION: This water well was plugged under my jurisdiction and was completed on (mo/day/year) **9-4-02** and this record is true to the best of my knowledge and belief. Kansas Water Well Contractor's License No. **665** This Water Well Record was completed on (mo/day/year) **9-5-02** under the business name of **PRATT WELL EXCAVATION**
by (signature) **Steven Egan**

INSTRUCTIONS: Use typewriter or ball point pen. Please press firmly and print clearly. Please fill in blanks, underline or circle the correct answers. Send top three copies to Kansas Department of Health and Environment, Bureau of Water, Topeka, Kansas 66620-0001. Telephone: 785/296-3565. Send one to Water Well Owner and retain one for your records.