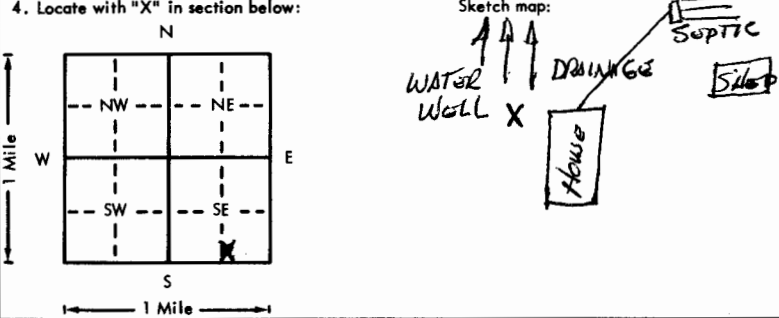


USE TYPEWRITER OR BALL
POINT PEN-PRESS FIRMLY,
PRINT CLEARLY.

WATER WELL RECORD
KSA 82a-1201-1215

Kansas Department of Health and
Environment-Division of Environment
(Water well Contractors)
Topeka, Kansas 66620

1. Location of well:		County PRATT	Fraction SW 1/4 SE 1/4 SE 1/4	Section number 5	Township number T 28 S	Range number R 12 E
2. Distance and direction from nearest town or city: 6 E 15 1/4 W OF PRATT				3. Owner of well: BILL ROBBINS		
Street address of well location if in city:				R.R. or street: City, state, zip code: PRATT, KS 67124		
4. Locate with "X" in section below:				Sketch map:		
				6. Bore hole dia. 10 in. Completion date 11 JAN 77 Well depth 50 ft.		
5. Type and color of material				7. <input checked="" type="checkbox"/> Cable tool <input checked="" type="checkbox"/> Rotary <input type="checkbox"/> Driven <input type="checkbox"/> Dug <input type="checkbox"/> Hollow rod <input type="checkbox"/> Jetted <input type="checkbox"/> Bored <input type="checkbox"/> Reverse rotary		
				8. Use: <input checked="" type="checkbox"/> Domestic <input type="checkbox"/> Public supply <input type="checkbox"/> Industry <input type="checkbox"/> Irrigation <input type="checkbox"/> Air conditioning <input type="checkbox"/> Stock <input type="checkbox"/> Lawn <input type="checkbox"/> Oil field water <input type="checkbox"/> Other		
				9. Casing: Material <input type="checkbox"/> Height: 12 in. Above or below Threaded <input type="checkbox"/> Welded <input type="checkbox"/> Surface <input type="checkbox"/> RMP <input checked="" type="checkbox"/> PVC <input type="checkbox"/> Weight <input type="checkbox"/> lbs./ft. Dia. 5 in. to 50 ft. depth Wall Thickness: inches or Dia. <input type="checkbox"/> in. to <input type="checkbox"/> ft. depth gage No. 258		
				10. Screen: Manufacturer's name JAL Type RMS Dia. 5" Slot/gauze Sawed 1/8 Length 10' Set between 40' ft. and 50 ft. ft. and <input type="checkbox"/> ft. Gravel pack? Yes Size range of material 1/8-1/2		
				11. Static water level: <input type="checkbox"/> mo./day/yr. 20 ft. below land surface Date 11 JAN 77		
				12. Pumping level below land surfaces: <input type="checkbox"/> ft. after <input type="checkbox"/> hrs. pumping <input type="checkbox"/> g.p.m. <input type="checkbox"/> ft. after <input type="checkbox"/> hrs. pumping <input type="checkbox"/> g.p.m. Estimated maximum yield 50 g.p.m.		
				13. Water sample submitted: <input type="checkbox"/> mo./day/yr. Yes <input checked="" type="checkbox"/> No <input type="checkbox"/> Date <input type="checkbox"/>		
				14. Well head completion: <input checked="" type="checkbox"/> Pitless adapter 12 inches above grade		
				15. Well grouted? Yes With: <input checked="" type="checkbox"/> Neat cement <input type="checkbox"/> Bentonite <input type="checkbox"/> Concrete Depth: From 4 ft. to 16 ft.		
				16. Nearest source of possible contamination: ft. 200 Direction ENE Type SEPTIC Well disinfected upon completion? <input checked="" type="checkbox"/> Yes <input type="checkbox"/> No		
				17. Pump: <input type="checkbox"/> Not installed Manufacturer's name Goulds Model number 2561 HP 1 Volts 230 Length of drop pipe 42 ft. capacity 20 g.p.m. Type: <input checked="" type="checkbox"/> Submersible <input type="checkbox"/> Turbine <input type="checkbox"/> Jet <input type="checkbox"/> Reciprocating <input type="checkbox"/> Centrifugal <input type="checkbox"/> Other		
				(Use a second sheet if needed)		
18. Elevation:		19. Remarks:		20. Water well contractor's certification:		
Topography: <input type="checkbox"/> Hill <input type="checkbox"/> Slope <input checked="" type="checkbox"/> Upland <input type="checkbox"/> Valley		4'x4'x4" CONCRETE SLAB AT BOTTOM OF PITLESS ADAPTER		This well was drilled under my jurisdiction and this report is true to the best of my knowledge and belief. Central Well & Pump 325 Business name License No. Address 124 S. TAYLOR, PRATT Signed John H. Hannon Date 3 FEB 77 Authorized representative		

Forward the white, blue and pink copies to the Department of Health and Environment

Form WWC-5