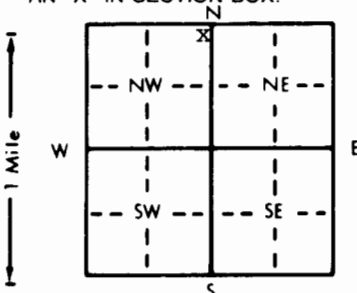


1 LOCATION OF WATER WELL: County: Pratt		Fraction NE 1/4 NE 1/4 NW 1/4		Section Number 26	Township Number T 28 S	Range Number R 13 E/W
Distance and direction from nearest town or city street address of well if located within city? Approximately 4 miles south and 1 1/2 miles east of Pratt						
2 WATER WELL OWNER: RR#, St. Address, Box # : City, State, ZIP Code :		Darrell Brehm Route 1 Pratt, KS 67124 Board of Agriculture, Division of Water Resources Application Number: 41,352				
3 LOCATE WELL'S LOCATION WITH AN "X" IN SECTION BOX: 		4 DEPTH OF COMPLETED WELL 207 ft. ELEVATION: unknown Depth(s) Groundwater Encountered 1. ft. 2. ft. 3. ft. WELL'S STATIC WATER LEVEL 103.37 ft. below land surface measured on mo/day/yr 12-6-96 Pump test data: Well water was not ch'd. ft. after hours pumping gpm Est. Yield unknown gpm: Well water was ft. after hours pumping gpm Bore Hole Diameter 6 3/4 in. to 215 ft. and in. to ft. WELL WATER TO BE USED AS: 5 Public water supply 8 Air conditioning 11 Injection well 1 Domestic 3 Feedlot 6 Oil field water supply 9 Dewatering 12 Other (Specify below) 2 Irrigation 4 Industrial 7 Lawn and garden only 10 Monitoring well Observation well Was a chemical/bacteriological sample submitted to Department? Yes No X If yes, mo/day/yr sample was submitted Water Well Disinfected? Yes No X				
5 TYPE OF BLANK CASING USED: 1 Steel 3 RMP (SR) 5 Wrought iron 8 Concrete tile CASING JOINTS: Glued X Clamped 2 PVC 4 ABS 6 Asbestos-Cement 9 Other (specify below) Welded Blank casing diameter 3 in. to 195 ft. Dia 3 in. to 205 ft. Dia in. to ft. Casing height above land surface 24 in. weight 1.96 lbs./ft. Wall thickness or gauge No. 300 TYPE OF SCREEN OR PERFORATION MATERIAL: 1 Steel 3 Stainless steel 5 Fiberglass 7 PVC 10 Asbestos-cement 2 Brass 4 Galvanized steel 6 Concrete tile 8 RMP (SR) 11 Other (specify) SCREEN OR PERFORATION OPENINGS ARE: 1 Continuous slot 3 Mill slot 5 Gauzed wrapped 8 Saw cut 11 None (open hole) 2 Louvered shutter 4 Key punched 6 Wire wrapped 9 Drilled holes SCREEN-PERFORATED INTERVALS: From 195 ft. to 200 ft. From ft. to ft. GRAVEL PACK INTERVALS: From 186 ft. to 210 ft. From ft. to ft. 6 GROUT MATERIAL: 1 Neat cement 2 Cement grout 3 Bentonite 4 Other Bentonite Holeplug Grout Intervals: From 0 ft. to 179 ft. From ft. to ft. From 179 ft. to 186 ft. What is the nearest source of possible contamination: 1 Septic tank 4 Lateral lines 7 Pit privy 10 Livestock pens 14 Abandoned water well 2 Sewer lines 5 Cess pool 8 Sewage lagoon 11 Fuel storage 15 Oil well/Gas well 3 Watertight sewer lines 6 Seepage pit 9 Feedyard 12 Fertilizer storage 16 Other (specify below) Direction from well? How many feet? 13 Insecticide storage None known 7 FROM TO LITHOLOGIC LOG FROM TO PLUGGING INTERVALS 0 6 Topsoil 6 17 Clay, reddish-brown, hard 17 20 Clay, tan, hard 20 50 Clay, brown, sandy, hard 50 66 Clay, white and brown, hard 66 75 Sand and gravel, medium and fine, loose, clean 75 81 Clay, tannish-white, hard 81 96 Sand and gravel, medium and fine, clean 96 106 Clay, gray, hard 106 201 Sand and gravel, coarse, medium and fine 201 215 Clay, tannish-red, hard 215 Shale, red, hard 8 CONTRACTOR'S OR LANDOWNER'S CERTIFICATION: This water well was (1) constructed, (2) reconstructed, or (3) plugged under my jurisdiction and was completed on (mo/day/year) 12-6-96 and this record is true to the best of my knowledge and belief. Kansas Water Well Contractor's License No. 185 This Water Well Record was completed on (mo/day/yr) 12-10-96 under the business name of Clarke Well & Equipment, Inc. by (signature) [Signature]						
INSTRUCTIONS: Use typewriter or ball point pen. PLEASE PRESS FIRMLY and PRINT clearly. Please fill in blanks, underline or circle the correct answers. Send top three copies to Kansas Department of Health and Environment, Bureau of Water, Topeka, Kansas 66620-0001. Telephone: 913-296-5545. Send one to WATER WELL OWNER and retain one for your records.						