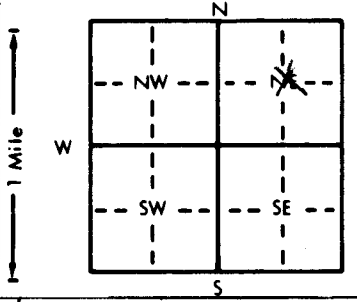


1 LOCATION OF WATER WELL:		Fraction	Section Number		Township Number		Range Number	
County: <u>Pratt</u>		<u>1/4</u> <u>C</u> <u>1/4</u> <u>NE</u> <u>1/4</u>	<u>21</u>		<u>T</u> <u>28</u> <u>S</u>		<u>R</u> <u>13</u> <u>EW</u>	
Distance and direction from nearest town or city street address of well if located within city? <u>2 1/2 south of Pratt, Ks.</u>								
2 WATER WELL OWNER: <u>Russell Fincham</u>								
RR#, St. Address, Box # : <u>20089 Lake Road</u>								
City, State, ZIP Code : <u>Pratt, Ks. 67124</u>								
Board of Agriculture, Division of Water Resources Application Number:								
3 LOCATE WELL'S LOCATION WITH AN "X" IN SECTION BOX:			4 DEPTH OF COMPLETED WELL <u>150</u> ft. ELEVATION:					
			Depth(s) Groundwater Encountered 1. .... ft. 2. .... ft. 3. .... ft.					
			WELL'S STATIC WATER LEVEL <u>7.9</u> ft. below land surface measured on mo/day/yr <u>3-22-99</u>					
			Pump test data: Well water was .... ft. after .... hours pumping .... gpm					
			Est. Yield <u>NA</u> gpm: Well water was .... ft. after .... hours pumping .... gpm					
			Bore Hole Diameter <u>7</u> in. to <u>152</u> ft., and .... in. to .... ft.					
WELL WATER TO BE USED AS:								
5 Public water supply 8 Air conditioning 11 Injection well								
1 Domestic 3 Feedlot 6 Oil field water supply 9 Dewatering 12 Other (Specify below)								
2 Irrigation 4 Industrial 7 Lawn and garden only 10 Monitoring well <u>live stock</u>								
Was a chemical/bacteriological sample submitted to Department? Yes.....No..... <u>X</u> ..... If yes, mo/day/yr sample was submitted								
Water Well Disinfected? Yes No <u>X</u>								
5 TYPE OF BLANK CASING USED:								
1 Steel 3 RMP (SR) 5 Wrought iron 8 Concrete tile CASING JOINTS: Glued <u>X</u> Clamped								
2 PVC 4 ABS 6 Asbestos-Cement 9 Other (specify below) Welded								
7 Fiberglass Threaded								
Blank casing diameter <u>4</u> in. to <u>130</u> ft., Dia. .... in. to .... ft., Dia. .... in. to .... ft.								
Casing height above land surface <u>2</u> in., weight <u>SDR 26</u> lbs./ft. Wall thickness or gauge No. ....								
TYPE OF SCREEN OR PERFORATION MATERIAL:								
1 Steel 3 Stainless steel 5 Fiberglass 7 PVC 10 Asbestos-cement								
2 Brass 4 Galvanized steel 6 Concrete tile 8 RMP (SR) 11 Other (specify)								
9 ABS 12 None used (open hole)								
SCREEN OR PERFORATION OPENINGS ARE:								
1 Continuous slot 3 Mill slot 5 Gauzed wrapped 8 Saw cut 11 None (open hole)								
2 Louvered shutter 4 Key punched 6 Wire wrapped 9 Drilled holes								
7 Torch cut 10 Other (specify)								
SCREEN-PERFORATED INTERVALS: From <u>130</u> ft. to <u>150</u> ft., From .... ft. to .... ft.								
GRAVEL PACK INTERVALS: From <u>152</u> ft. to <u>20</u> ft., From .... ft. to .... ft.								
6 GROUT MATERIAL: 1 Neat cement 2 Cement grout 3 Bentonite 4 Other <u>hole plug</u>								
Grout Intervals: From <u>20</u> ft. to <u>0</u> ft., From .... ft. to .... ft.								
What is the nearest source of possible contamination:								
1 Septic tank 4 Lateral lines 7 Pit privy 10 Livestock pens 14 Abandoned water well								
2 Sewer lines 5 Cess pool 8 Sewage lagoon 11 Fuel storage 15 Oil well/Gas well								
3 Watertight sewer lines 6 Seepage pit 9 Feedyard 12 Fertilizer storage 16 Other (specify below)								
13 Insecticide storage none								
Direction from well? How many feet?								
FROM TO LITHOLOGIC LOG FROM TO PLUGGING INTERVALS								
0 3 Top Soil 115 116 1/2 Clay								
3 5 Tough brown clay 116 1/2 152 Sand and gravel clean coarse and loose								
5 22 Brown and white clay								
22 28 Sand and clay mixed								
28 31 Brown clay								
31 40 Sand and gravel								
40 54 Gray and white clay								
54 67 Brown and white clay								
67 77 Sand and gravel with clay and white rock								
77 92 Sand and gravel clean, coarse and loose								
92 95 Brown clay								
95 115 Sand and gravel clean coarse and loose								
7 CONTRACTOR'S OR LANDOWNER'S CERTIFICATION: This water well was (1) <u>constructed</u> , (2) reconstructed, or (3) plugged under my jurisdiction and was completed on (mo/day/year) <u>5-4-99</u> and this record is true to the best of my knowledge and belief. Kansas Water Well Contractor's License No. <u>134</u> This Water Well Record was completed on (mo/day/yr) <u>6-2-99</u> under the business name of <u>Rosencrantz-Bemis</u> by (signature) <u>Gredia Rudson</u>								