

1 LOCATION OF WATER WELL:	Fraction	Section Number	Township Number	Range Number
County: <u>PRATT</u>	<u>SW 1/4 NE 1/4 NE 1/4</u>	<u>9</u>	T <u>28</u> S <u>13</u>	R <u>13</u> EW <u>13</u>

Distance and direction from nearest town or city street address of well if located within city?

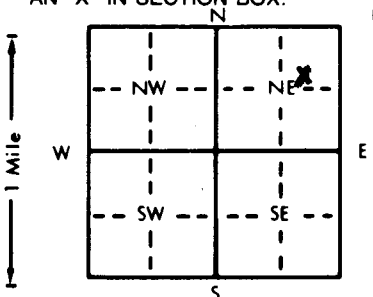
1/2 mile South of The Lake Rd & 281 Hwy on The West Side2 WATER WELL OWNER: DAN KEMMISRR#, St. Address, Box #: 10257 S. Hwy 281

Board of Agriculture, Division of Water Resources

City, State, ZIP Code: PRATT, KS 67124

Application Number:

3 LOCATE WELL'S LOCATION WITH AN "X" IN SECTION BOX:


WELL WATER TO BE USED AS:

- |              |              |                          |                    |                          |
|--------------|--------------|--------------------------|--------------------|--------------------------|
| 1 Domestic   | 3 Feedlot    | 6 Oil field water supply | 9 Dewatering       | 12 Other (Specify below) |
| 2 Irrigation | 4 Industrial | 7 Lawn and garden only   | 10 Monitoring well |                          |

Was a chemical/bacteriological sample submitted to Department? Yes No X; If yes, mo/day/yr sample was submittedWater Well Disinfected? Yes X No

5 TYPE OF BLANK CASING USED:

- |         |            |
|---------|------------|
| 1 Steel | 3 RMP (SR) |
| 2 PVC   | 4 ABS      |

5 Wrought iron

8 Concrete tile

CASING JOINTS: Glued X Clamped

6 Asbestos-Cement

9 Other (specify below)

Welded

7 Fiberglass

Threaded


TYPE OF SCREEN OR PERFORATION MATERIAL:

- |         |                    |
|---------|--------------------|
| 1 Steel | 3 Stainless steel  |
| 2 Brass | 4 Galvanized steel |

5 Fiberglass

8 RMP (SR)

10 Asbestos-cement

11 Other (specify)

6 Concrete tile

9 ABS

12 None used (open hole)

SCREEN OR PERFORATION OPENINGS ARE:

- |                    |               |
|--------------------|---------------|
| 1 Continuous slot  | 3 Mill slot   |
| 2 Louvered shutter | 4 Key punched |

.020

5 Gauzed wrapped

8 Saw cut

11 None (open hole)

6 Wire wrapped

9 Drilled holes

7 Torch cut

10 Other (specify)


6 GROUT MATERIAL:

1 Neat cement

2 Cement grout

3 Bentonite

4 Other


What is the nearest source of possible contamination:

- |                          |                 |
|--------------------------|-----------------|
| 1 Septic tank            | 4 Lateral lines |
| 2 Sewer lines            | 5 Cess pool     |
| 3 Watertight sewer lines | 6 Seepage pit   |

7 Pit privy

8 Sewage lagoon

9 Feedyard

10 Livestock pens

14 Abandoned water well

11 Fuel storage

15 Oil well/Gas well

12 Fertilizer storage

16 Other (specify below)

13 Insecticide storage


FROM	TO	LITHOLOGIC LOG	FROM	TO	PLUGGING INTERVALS
0"	3'	Top Soil/Clay & Silt			
3'	5'	Trace of lt. Ben clay & fine sand			
5'	10'	Fine sand mixed w/ med sand			
10'	15'	Med. sand			
15'	17'	Trace of tan clay & med sand			
17'	20'	Tan clay w/ med sand			
20'	25'	Coarse sand mixed w/ tan clay			
25'	30'	Large sand mixed w/ Ben & tan clay			
30'	40'	" " " "			
40'	45'	Coarse sand mixed w/ caliche			
45'	55'	" " " "			
55'	75'	Med sand mixed with fine sugar sand			

7 CONTRACTOR'S OR LANDOWNER'S CERTIFICATION: This water well was (1) constructed, (2) reconstructed, or (3) plugged under my jurisdiction and was completed on (mo/day/year) 1-7-02 and this record is true to the best of my knowledge and belief. KansasWater Well Contractor's License No. 665 This Water Well Record was completed on (mo/day/yr) 1-24-02under the business name of PRATT WELL SERVICE ENVIRONMENTAL (signature) Steven Egan