


1 LOCATION OF WATER WELL: County: Pratt	Fraction NE 1/4 NE 1/4 NE 1/4	Section 27	Township Number T 28 S	Range Number R 13w E/W
---	---	----------------------	----------------------------------	----------------------------------

Distance and direction from nearest town or city street address of well if located within city?

3S of Pratt, Ks.

2	WATER WELL OWNER: Satosek Partners	Sterling Drilling Company	Satosek
	RR#, St. Address, Box # c/o Jack Spines	P. O. Box 1006	Board of Agriculture, Division of Water Resources
	City, State, ZIP Code 8911 East Douglas	Pratt, Ks. 67124	Application Number: 20030010

3 LOCATE WELL'S LOCATION WITH AN "X" IN SECTION BOX: 4 DEPTH OF COMPLETED WELL.....192..... ft. ELEVATION: unknown.....

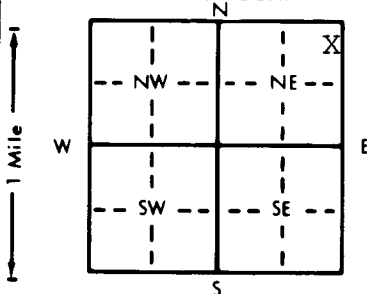

Depth(s) Groundwater Encountered 1. 90 ft. 2. ft. 3. ft.
WELL'S STATIC WATER LEVEL . . . 90 ft. below land surface measured on mo/day/yr 01/28/03

Pump test data:	Well water was	ft. after	hours pumping	gpm
Est. Yield . . . 60 . . . gpm:	Well water was	ft. after	hours pumping	gpm
Bore Hole Diameter . . . 1.92 in. to	ft., and	in. to	ft.	

WELL WATER TO BE USED AS:			
1 Domestic	3 Feedlot	5 Public water supply	8 Air conditioning
2 Irrigation	4 Industrial	6 <u>Oil field water supply</u>	9 Dewatering
		7 Lawn and garden only	10 Monitoring well
			11 Injection well
			12 Other (Specify below)

Was a chemical/bacteriological sample submitted to Department? Yes.....No.....; If yes, mo/day/yr sample was submitted

Water Well Disinfected? Yes No

5	TYPE OF BLANK CASING USED:		5 Wrought iron	8 Concrete tile	CASING JOINTS: <u>Glued</u> Clamped Welded Threaded
	1 Steel	3 RMP (SR)	6 Asbestos-Cement	9 Other (specify below)	
	2 PVC	4 ABS	7 Fiberglass		

Blank casing diameter 5 in. to 152 ft. Dia in. to ft. Dia in. to ft.
Casing height above land surface 12 in. weight 2.8 lbs./ft. Wall thickness or gauge No. Sch. 40

TYPE OF SCREEN OR PERFORATION MATERIAL:			7 PVC	10 Asbestos-cement
1 Steel	3 Stainless steel	5 Fiberglass	8 RMP (SR)	11 Other (specify)
2 Brass	4 Galvanized steel	6 Concrete tile	9 ABS	12 None used (open hole)

SCREEN OR PERFORATION OPENINGS ARE:		5 Gauzed wrapped	8 Saw cut	11 None (open hole)
1 Continuous slot	3 Mill slot	6 Wire wrapped	9 Drilled holes	
2 Louvered shutter	4 Key punched	7 Torch cut	10 Other (specify)	

SCREEN-PERFORATED INTERVALS:	From 152	ft. to . . . 192	ft. From	ft. to	ft.
	From	ft. to	ft. From	ft. to	ft.
GRAVEL PACK INTERVALS:	From 21	ft. to . . . 192	ft. From	ft. to	ft.
	From	ft. to	ft. From	ft. to	ft.

6 GROUT MATERIAL: 1 Neat cement 2 Cement grout 3 Bentonite 4 Other

Grout Intervals: From 0 ft. to 21 ft. From ft. to ft. From ft. to ft.

What is the nearest source of possible contamination:

1 Septic tank	4 Lateral lines	7 Pit privy	10 Livestock pens	14 Abandoned water well
2 Sewer lines	5 Cess pool	8 Sewage lagoon	11 Fuel storage	15 Oil well/Gas well
3 Watertight sewer lines	6 Seepage pit	9 Feedyard	12 Fertilizer storage	16 Other (specify below)
			13 Insecticide storage	

Direction from well? West

How many feet? 100

[illegible]

7 CONTRACTOR'S OR LANDOWNER'S CERTIFICATION: This water well was (1) constructed, (2) reconstructed, or (3) plugged under my jurisdiction and was completed on (mo/day/year) 01/28/03 and this record is true to the best of my knowledge and belief. Kansas Water Well Contractor's License No. 186 This Water Well Record was completed on (mo/day/yr) 01/30/03 under the business name of Kelly's Water Well Service, Inc. by (signature) *Kelly's Water Well Service*