

1	LOCATION OF WATER WELL:	Fraction	Section Number	Township Number	Range Number
County:	Pratt	NE ¼ NE ¼ NE ¼	27	T 28 S	R 13w E/W


Distance and direction from nearest town or city street address of well if located within city?

3Sof Pratt, Ks.

2	WATER WELL OWNER: Satosek Partners c/o Jack Spines RR#, St. Address, Box # : 8911 East Douglas City, State, ZIP Code : Wichita, Ks. 67207	Sterling Drilling Company P. O. Box 1006 Pratt, Ks. 67124	satosek Board of Agriculture, Division of Water Resources Application Number:
---	--	---	---

3 LOCATE WELL'S LOCATION WITH 4 DEPTH OF COMPLETED WELL 192 ft. ELEVATION: unknown

AN "X" IN SECTION BOX:

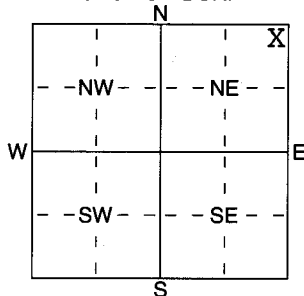

Depth(s) Groundwater Encountered 1 90 ft. 2 _____ ft. 3 _____ ft.
WELL'S STATIC WATER LEVEL 90 ft. below land surface measured on mo/day/yr 11/07/03
Pump test data: Well water was _____ ft. after _____ hours pumping _____ gpm
Est. Yield 60 gpm: Well water was _____ ft. after _____ hours pumping _____ gpm
WELL WATER TO BE USED AS:
1 Domestic 3 Feedlot 5 Public water supply 8 Air conditioning 11 Injection well
2 Irrigation 4 Industrial 6 Oil field water supply 9 Dewatering 12 Other (Specify below)
7 Domestic (lawn & garden) 10 Monitoring well

Was a chemical/bacteriological sample submitted to Department? Yes No ; If yes, mo/day/yr sample was submitted
Water Well Disinfected? Yes _____ No _____

5	TYPE OF BLANK CASING USED:		5 Wrought iron	8 Concrete tile	CASING JOINTS: <u>Glued</u> Clamped	
	1 Steel	3 RMP (SR)	6 Asbestos-Cement	9 Other (specify below)		Welded
	2 <u>PVC</u>	4 ABS	7 Fiberglass			Threaded

Blank casing diameter 5 in. to 152 ft., Dia _____ in. to _____ ft., Dia _____ in. to _____ ft.

Casing height above land surface 3 ft. below in., weight lbs./ft. Wall thickness or gauge No.

TYPE OF SCREEN OR PERFORATION MATERIAL:

1 Steel	3 Stainless Steel	5 Fiberglass	7 PVC	10 Asbestos-Cement
2 Brass	4 Galvanized Steel	6 Concrete tile	8 RMP (SR)	11 Other (Specify)
			9 ABS	12 None used (open hole)

SCREEN OR PERFORATION OPENINGS ARE:

1 Continuous slot	3 Mill slot	5 Guazed wrapped	8 <u>Saw cut</u>	11 None (open hole)
2 Louvered shutter	4 Key punched	6 Wire wrapped	9 Drilled holes	
		7 Torch cut	10 Other (specify)	ft.

SCREEN-PERFORATED INTERVALS: From 152 ft. to 192 ft., From _____ ft. to _____ ft.
From _____ ft. to _____ ft., From _____ ft. to _____ ft.

GRAVEL PACK INTERVALS: From 21 ft. to 192 ft., From _____ ft. to _____ ft.
From _____ ft. to _____ ft., From _____ ft. to _____ ft.

6	GROUT MATERIAL:				1 Neat cement	2 Cement grout	3 <u>Bentonite</u>	4 Other						
Grout Intervals:		From	<u>3</u>	ft. to	<u>20</u>	ft., From	<u>85</u>	ft. to	<u>90</u>	ft., From		ft. to		ft.

What is the nearest source of possible contamination:

1 Septic tank	4 Lateral lines	7 Pit privy	10 Livestock pens	14 Abandoned water well
2 Sewer lines	5 Cess pool	8 Sewage lagoon	11 Fuel storage	15 Oil well/Gas well
3 Watertight sewer lines	6 Seepage pit	9 Feedyard	12 Fertilizer storage	16 Other (specify below)
			13 Insecticide storage	

Direction from well? _____ How many feet? _____

[illegible]

7 CONTRACTOR'S OR LANDOWNER'S CERTIFICATION: This water well was (1) constructed, (2) reconstructed, or (3) plugged under my jurisdiction and was completed on (mo/day/year) 11/07/03 and this record is true to the best of my knowledge and belief. Kansas Water Well Contractor's Licence No 186 This Water Well Record was completed on (mo/day/yr) 11/14/03 under the business name of Kelly's Water Well Service, Inc. by (signature) Matthew L. Ford