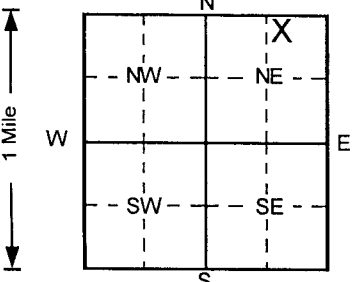


1 LOCATION OF WATER WELL: County: Pratt	Fraction NW ¼ NE ¼ NE ¼	Section Number 3	Township Number T 28 S	Range Number R 13 E
---	-----------------------------------	----------------------------	----------------------------------	-------------------------------

Distance and direction from nearest town or city street address of well if located within city?

1230 E. First St., Pratt, Kansas

2 WATER WELL OWNER: RR#, St. Address, Box # : City, State, ZIP Code :	STEVE WRIGHT 1230 E. FIRST PRATT, KS 67124	Board of Agriculture, Division of Water Resources Application Number:
---	---	--

3 LOCATE WELL'S LOCATION WITH AN "X" IN SECTION BOX: 	4 DEPTH OF COMPLETED WELL 70 ft. ELEVATION: 1885.95 Depth(s) Groundwater Encountered 1. 60 ft. 2. ft. 3. ft. WELL'S STATIC WATER LEVEL ft. below land surface measured on mo/day/yr Pump test data: Well water was NA ft. after hours pumping gpm Est. Yield .. NA .. gpm: Well water was ft. after hours pumping gpm Bore Hole Diameter 2 in. to 70 ft., and in. to ft. WELL WATER TO BE USED AS: 5 Public water supply 8 Air conditioning 11 Injection well 1 Domestic 3 Feedlot 6 Oil field water supply 9 Dewatering 12 Other (Specify below) 2 Irrigation 4 Industrial 7 Lawn and garden only 10 Monitoring well Was a chemical/bacteriological sample submitted to Department? Yes.....No <input checked="" type="checkbox"/> ; If yes, mo/day/yr sample was submitted Water Well Disinfected? Yes No <input checked="" type="checkbox"/>
--	---

5 TYPE OF BLANK CASING USED: 1 Steel 3 RMP (SR) 5 Wrought iron 8 Concrete tile 2 PVC 4 ABS 6 Asbestos-Cement 9 Other (specify below) Blank casing diameter 2 in. to 50 ft., Dia in. to ft., Dia in. to ft. Casing height above land surface -6.36 in., weight lbs./ft. Wall thickness or gauge No. Sch. 40 TYPE OF SCREEN OR PERFORATION MATERIAL 1 Steel 3 Stainless steel 5 Fiberglass 7 PVC 10 Asbestos-cement 2 Brass 4 Galvanized steel 6 Concrete tile 8 RMP (SR) 11 Other (specify) 12 None used (open hole) SCREEN OR PERFORATION OPENINGS ARE: 1 Continuous slot 3 Mill slot 5 Gauzed wrapped 8 Saw cut 11 None (open hole) 2 Louvered shutter 4 Key punched 6 Wire wrapped 9 Drilled holes 7 Torch cut 10 Other (specify) SCREEN-PERFORATED INTERVALS: From 50 ft. to 70 ft., From ft. to ft. From ft. to ft., From ft. to ft. GRAVEL PACK INTERVALS: From 48 ft. to 70 ft., From ft. to ft. From ft. to ft., From ft. to ft.

6 GROUT MATERIAL: 1 Neat cement 2 Cement grout 3 Bentonite 4 Other Grout Intervals: From 0 ft. to 2 ft., From 2 ft. to 48 ft., From ft. to ft. What is the nearest source of possible contamination: 1 Septic tank 4 Lateral lines 7 Pit privy 10 Livestock pens 14 Abandoned water well 2 Sewer lines 5 Cess pool 8 Sewage lagoon 11 Fuel storage 15 Oil well/Gas well 3 Watertight sewer lines 6 Seepage pit 9 Feedyard 12 Fertilizer storage 16 Other (specify below) Former UST Basin Direction from well? NW How many feet? 55
--

FROM	TO	LITHOLOGIC LOG	FROM	TO	PLUGGING INTERVALS
0	0.5	Concrete			
0.5	3	Clay, silty, v. plastic, moist, Tan			
3	8	Silt, clayey, sl. moist, v. plastic, Tan			
8	13	Clay, v. silty, plastic, v. moist, Lt. Tan			
13	18	Sand, vf-f grained, sl. moist, Brown			
18	25	Sand, vf grained, v. silty, v. clayey, sl. moist, R			
25	32	Sand, f-m grained, sl. silty, no odor, Lt. Brown			
32	41	Clay, v. firm, v. sl. moist, Brown mot. white			
41	46.5	Clay, v. silty, sandy, sl. moist, sl. plastic, Brow			
46.5	48	Sand, vf-f grained, v. silty, v. clayey, Reddish			
48	60	Sand, vf-m grained, moist, sat. @ 60', Brown			
60	70	Sand, vf-m grained, v. silty, sat., Brown			
					MW8R, Tag # 00310714, Flushmount
					Project Name: Al's Party Pak - Monitoring
					GeoCore # 727, KDHE # UI 076 00679

7 CONTRACTOR'S OR LANDOWNER'S CERTIFICATION: This water well was (1) constructed, (2) reconstructed, or (3) plugged under my jurisdiction and was completed on (mo/day/year) 5/17/2004 and this record is true to the best of my knowledge and belief. Kansas Water Well Contractor's License No. 527 This Water Well Record was completed on (mo/day/yr) 5/21/2004 under the business name of GeoCore, Inc. by (signature) <i>Dan Bell</i>
