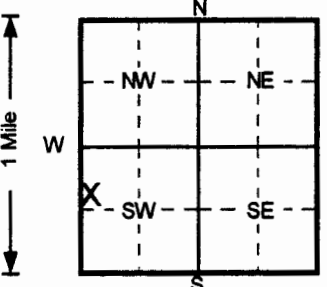


1 LOCATION OF WATER WELL: County: Pratt		Fraction SW ¼ NW ¼ SW ¼	Section Number 3	Township Number T 28 S	Range Number R 13 E/W
Distance and direction from nearest town or city street address of well if located within city? 916 South Main, Pratt, KS					
2 WATER WELL OWNER: Iuka Co-op Exchange RR#, St. Address, Box # : 102 N. Main City, State, ZIP Code : Iuka, Kansas Board of Agriculture, Division of Water Resources Application Number:					
3 LOCATE WELL'S LOCATION WITH AN "X" IN SECTION BOX: 		4 DEPTH OF COMPLETED WELL: 16 ft. ELEVATION: 999 Depth(s) Groundwater Encountered 1. _____ ft. 2. _____ ft. 3. _____ ft. WELL'S STATIC WATER LEVEL _____ ft. below land surface measured on mo/day/yr Pump test data: Well water was NA ft. after _____ hours pumping _____ gpm Est. Yield NA gpm: Well water was _____ ft. after _____ hours pumping _____ gpm Bore Hole Diameter 11 in. to 16 in. and _____ in. to _____ ft. WELL WATER TO BE USED AS: 5 Public water supply 8 Air conditioning 11 Injection well 1 Domestic 3 Feedlot 6 Oil field water supply 9 Dewatering 12 Other (Specify below) 2 Irrigation 4 Industrial 7 Lawn and garden only 10 Monitoring well Was a chemical/bacteriological sample submitted to Department? Yes _____ No ✓ ; If yes, mo/day/yr sample was submitted Water Well Disinfected? Yes _____ No ✓			
5 TYPE OF BLANK CASING USED: 1 Steel 3 RMP (SR) 5 Wrought iron 8 Concrete tile CASING JOINTS: Glued _____ Clamped _____ 2 PVC 4 ABS 6 Asbestos-Cement 9 Other (specify below) Welded _____ Blank casing diameter _____ in. to _____ ft. Dia. _____ in. to _____ ft. Dia. _____ in. to _____ ft. Casing height above land surface _____ in., weight Sch 40 lbs./ft. Wall thickness or gauge No. _____ TYPE OF SCREEN OR PERFORATION MATERIAL 1 Steel 3 Stainless steel 5 Fiberglass 7 PVC 10 Asbestos-cement 2 Brass 4 Galvanized steel 6 Concrete tile 8 RMP (SR) 11 Other (specify) _____ 9 ABS 12 None used (open hole) SCREEN OR PERFORATION OPENINGS ARE: 1 Continuous slot 3 Mill slot 5 Gauzed wrapped 8 Saw cut 11 None (open hole) 2 Louvered shutter 4 Key punched 6 Wire wrapped 9 Drilled holes 7 Torch cut 10 Other (specify) _____ SCREEN-PERFORATED INTERVALS: From _____ ft. to _____ ft. From _____ ft. to _____ ft. From _____ ft. to _____ ft. From _____ ft. to _____ ft. GRAVEL PACK INTERVALS: From 5 ft. to 16 ft. From _____ ft. to _____ ft. From _____ ft. to _____ ft. From _____ ft. to _____ ft.					
6 GROUT MATERIAL: 1 Neat cement 2 Cement grout 3 Bentonite 4 Other _____ Grout Intervals: From _____ ft. to 3 ft. From 3 ft. to 5 ft. From _____ ft. to _____ ft. What is the nearest source of possible contamination: 1 Septic tank 4 Lateral lines 7 Pit privy 10 Livestock pens 14 Abandoned water well 2 Sewer lines 5 Cess pool 8 Sewage lagoon 11 Fuel storage 15 Oil well/Gas well 3 Watertight sewer lines 6 Seepage pit 9 Feedyard 12 Fertilizer storage 16 Other (specify below) 13 Insecticide storage _____ Direction from well? _____ How many feet? _____ FROM TO LITHOLOGIC LOG FROM TO PLUGGING INTERVALS 0 0.5 Concrete, 0.5 2 Sand (Fill), 2 7 Clay, Brown 7 12 Clay, Gray/Dark Brown 12 14 Clay, Gray/Green 14 16 Sand, Gray SVE3, Tag #, Flushmount Project Name: AG.W - Iuka/Pratt GeoCore # 645, #					
7 CONTRACTOR'S OR LANDOWNER'S CERTIFICATION: This water well was 1 constructed, 2 reconstructed, or 3 plugged under my jurisdiction and was completed on (mo/day/year) 8/27/1998 and this record is true to the best of my knowledge and belief. Kansas Water Well Contractor's License No. 527 This Water Well Record was completed on (mo/day/yr) 9/25/1998 under the business name of GeoCore Services, Inc. by (signature) <i>Dale Bell</i>					