

SE $\frac{1}{4}$	SW $\frac{1}{4}$	NW $\frac{1}{4}$
------------------	------------------	------------------

BIG BEND GMD#5-KGS  
WATER QUALITY  
OBSERVATION WELL  
NETWORK

SITE NUMBER : 42

LEGAL LOCATION: 1-28-13W




SITE LOCATION: ~~SE SW NW~~

COUNTY : PRATT

CBA corrected 8-6-87


## WELL LOG

[illegible]

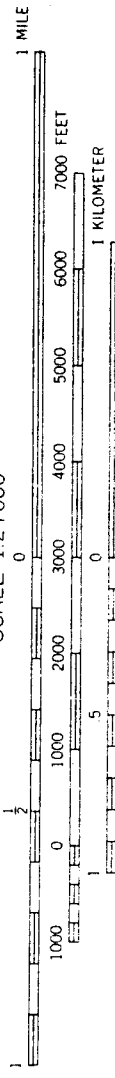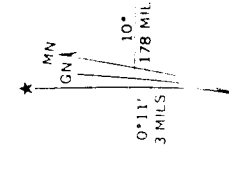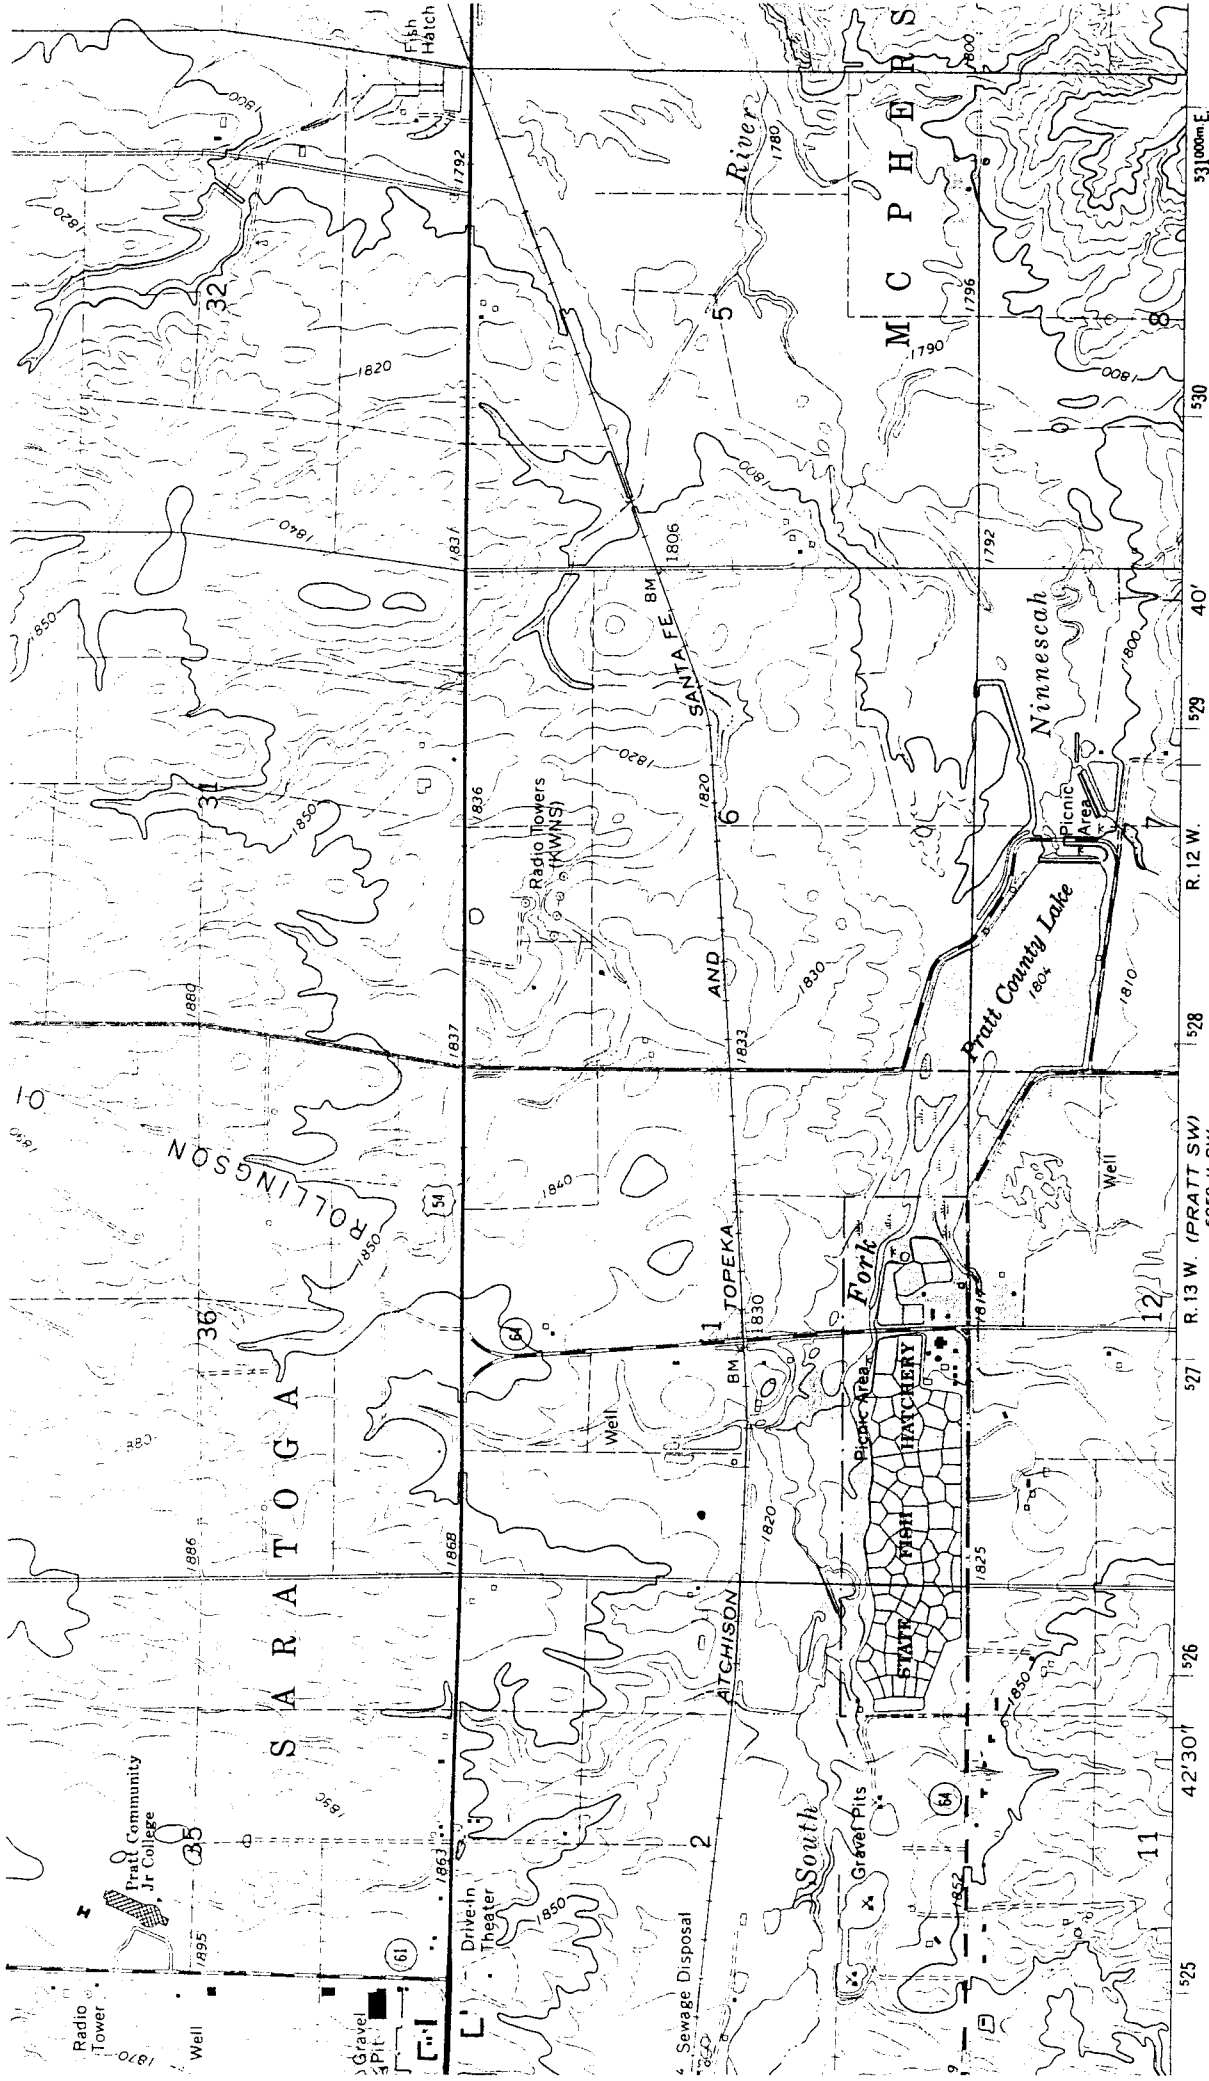

CONTOUR INTERVAL 10 FEET  
 DATUM IS MEAN SEA LEVEL

# PRATT Quadrangle

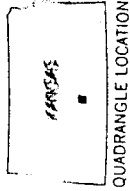


10 AND 1968 MAGNETIC NORTH  
 DATUM AT CENTER OF SHEET

THIS MAP COMPLIES WITH NATIONAL MAP ACCURACY STANDARDS  
 FOR SALE BY U. S. GEOLOGICAL SURVEY, DENVER, COLORADO 80225, OR WASHINGTON, D. C. 20242

He  
 Me

SITE NUMBER : 42 CBA  
SITE LOCATION : SE SW 1/4  
LEGAL LOCATION: 1-28-13W  
COUNTY : PRATT

LANDOWNER: VERNON HILLARD  
ADDRESS : RT. 1  
PRATT, KS  
PHONE NO.: (316)-672-6177

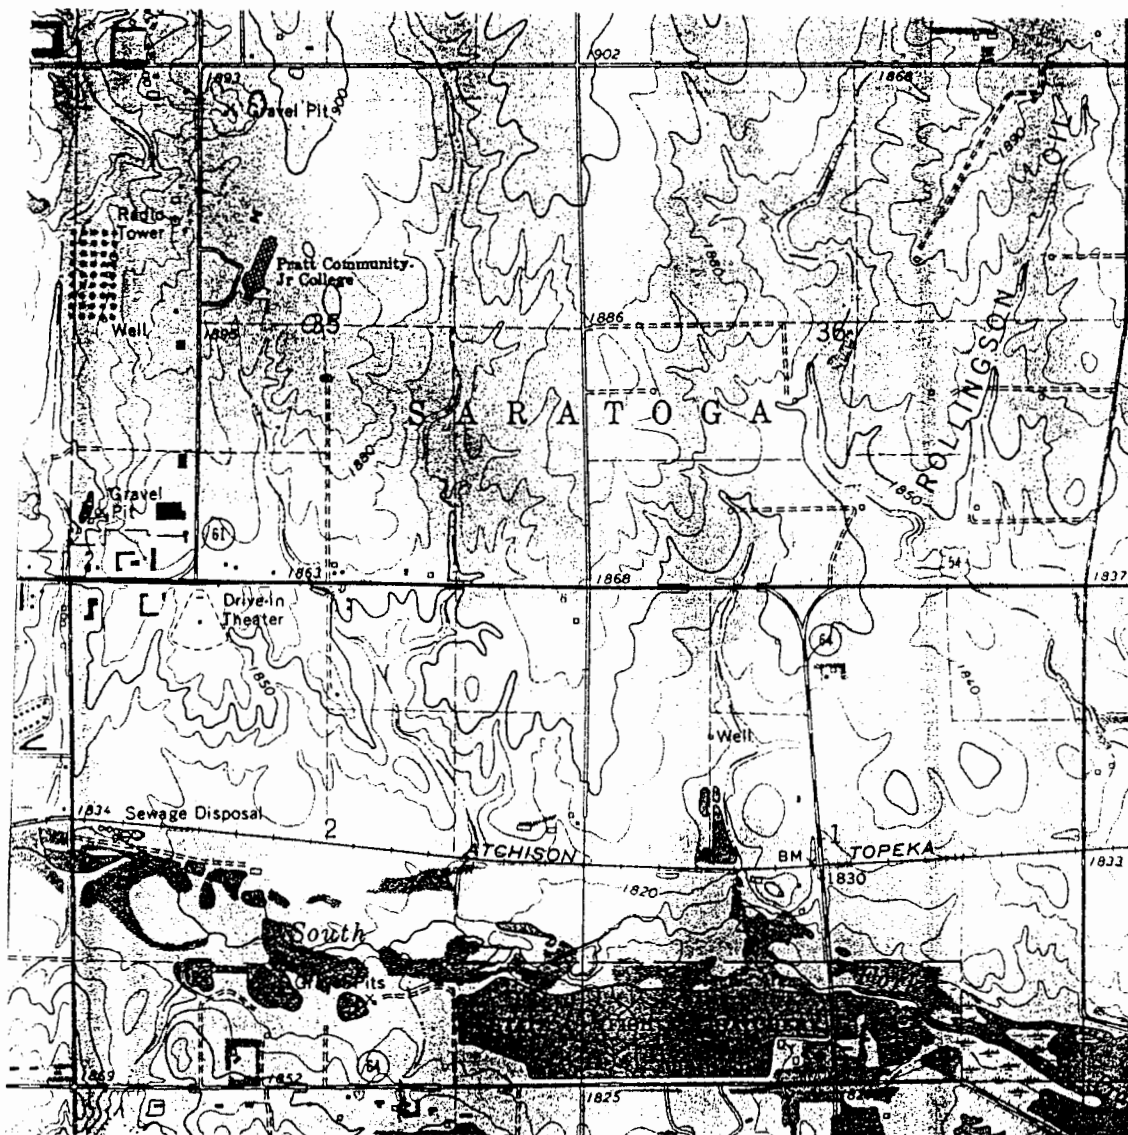

WELL LOCATION X