

$\frac{1}{4}$

BIG BEND GMD#5-KGS  
WATER QUALITY  
OBSERVATION WELL  
NETWORK

SITE NUMBER : 42

LEGAL LOCATION: 1-28-13W

SITE LOCATION: ~~SE SW NW~~

COUNTY : PRATT

CBA corrected 8-6-87



## WELL LOG

| FROM               | TO                  | LITHOLOGIC LOG                                                                           | OWNER: |
|--------------------|---------------------|------------------------------------------------------------------------------------------|--------|
|                    |                     | HILLARD                                                                                  |        |
| 0                  | 6                   | dark brown slightly sandy clay (soil)                                                    |        |
| 6                  | 17                  | light brown silty clay, some caliche stringers,<br>not much sand, fairly loose clay      |        |
| 17                 | 18                  | fine to medium sand                                                                      |        |
| 18                 | 25                  | dark brown sandy clay                                                                    |        |
| 25                 | 29                  | coarse sand and gravel                                                                   |        |
| 29                 | 33                  | tan sandy clay                                                                           |        |
| 33                 | 35                  | sand and gravel                                                                          |        |
| 35                 | 40                  | dark grey-brown clay, little silt; interbedded<br>with orange-brown silty clay           |        |
| 40                 | 43                  | sandy clay, same color as before                                                         |        |
| 43                 | 109                 | gravel and sand, very coarse; some clay layers<br>possible clay layer from 103' to 109'  |        |
| 109                | 110                 | possible lime layer                                                                      |        |
| 110                | 113                 | yellow-tan silty clay                                                                    |        |
| 113                | 114                 | more lime                                                                                |        |
| 114                | 117                 | clay, same as from 110' to 113'                                                          |        |
| 117                | 121                 | coarse sand and gravel, not much quartz                                                  |        |
| 121                | 123                 | tan silty clay                                                                           |        |
| 123                | 158                 | lime and clay like before, becoming dark grey<br>slightly silty clay, partially cemented |        |
| 158                | <del>164</del> /160 | sand and gravel interbedded with flesh colored<br>slightly sandy clay                    |        |
| <del>160-164</del> | 183                 | red shale--PERMIAN                                                                       |        |



(N) ↗

③      ②      ①

|                    |                    |                    |
|--------------------|--------------------|--------------------|
| TD=108'<br>103'/5' | TD=162'<br>157'/5' | TD=183'<br>178'/5' |
|--------------------|--------------------|--------------------|

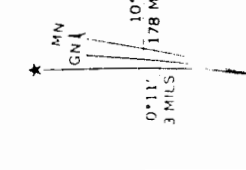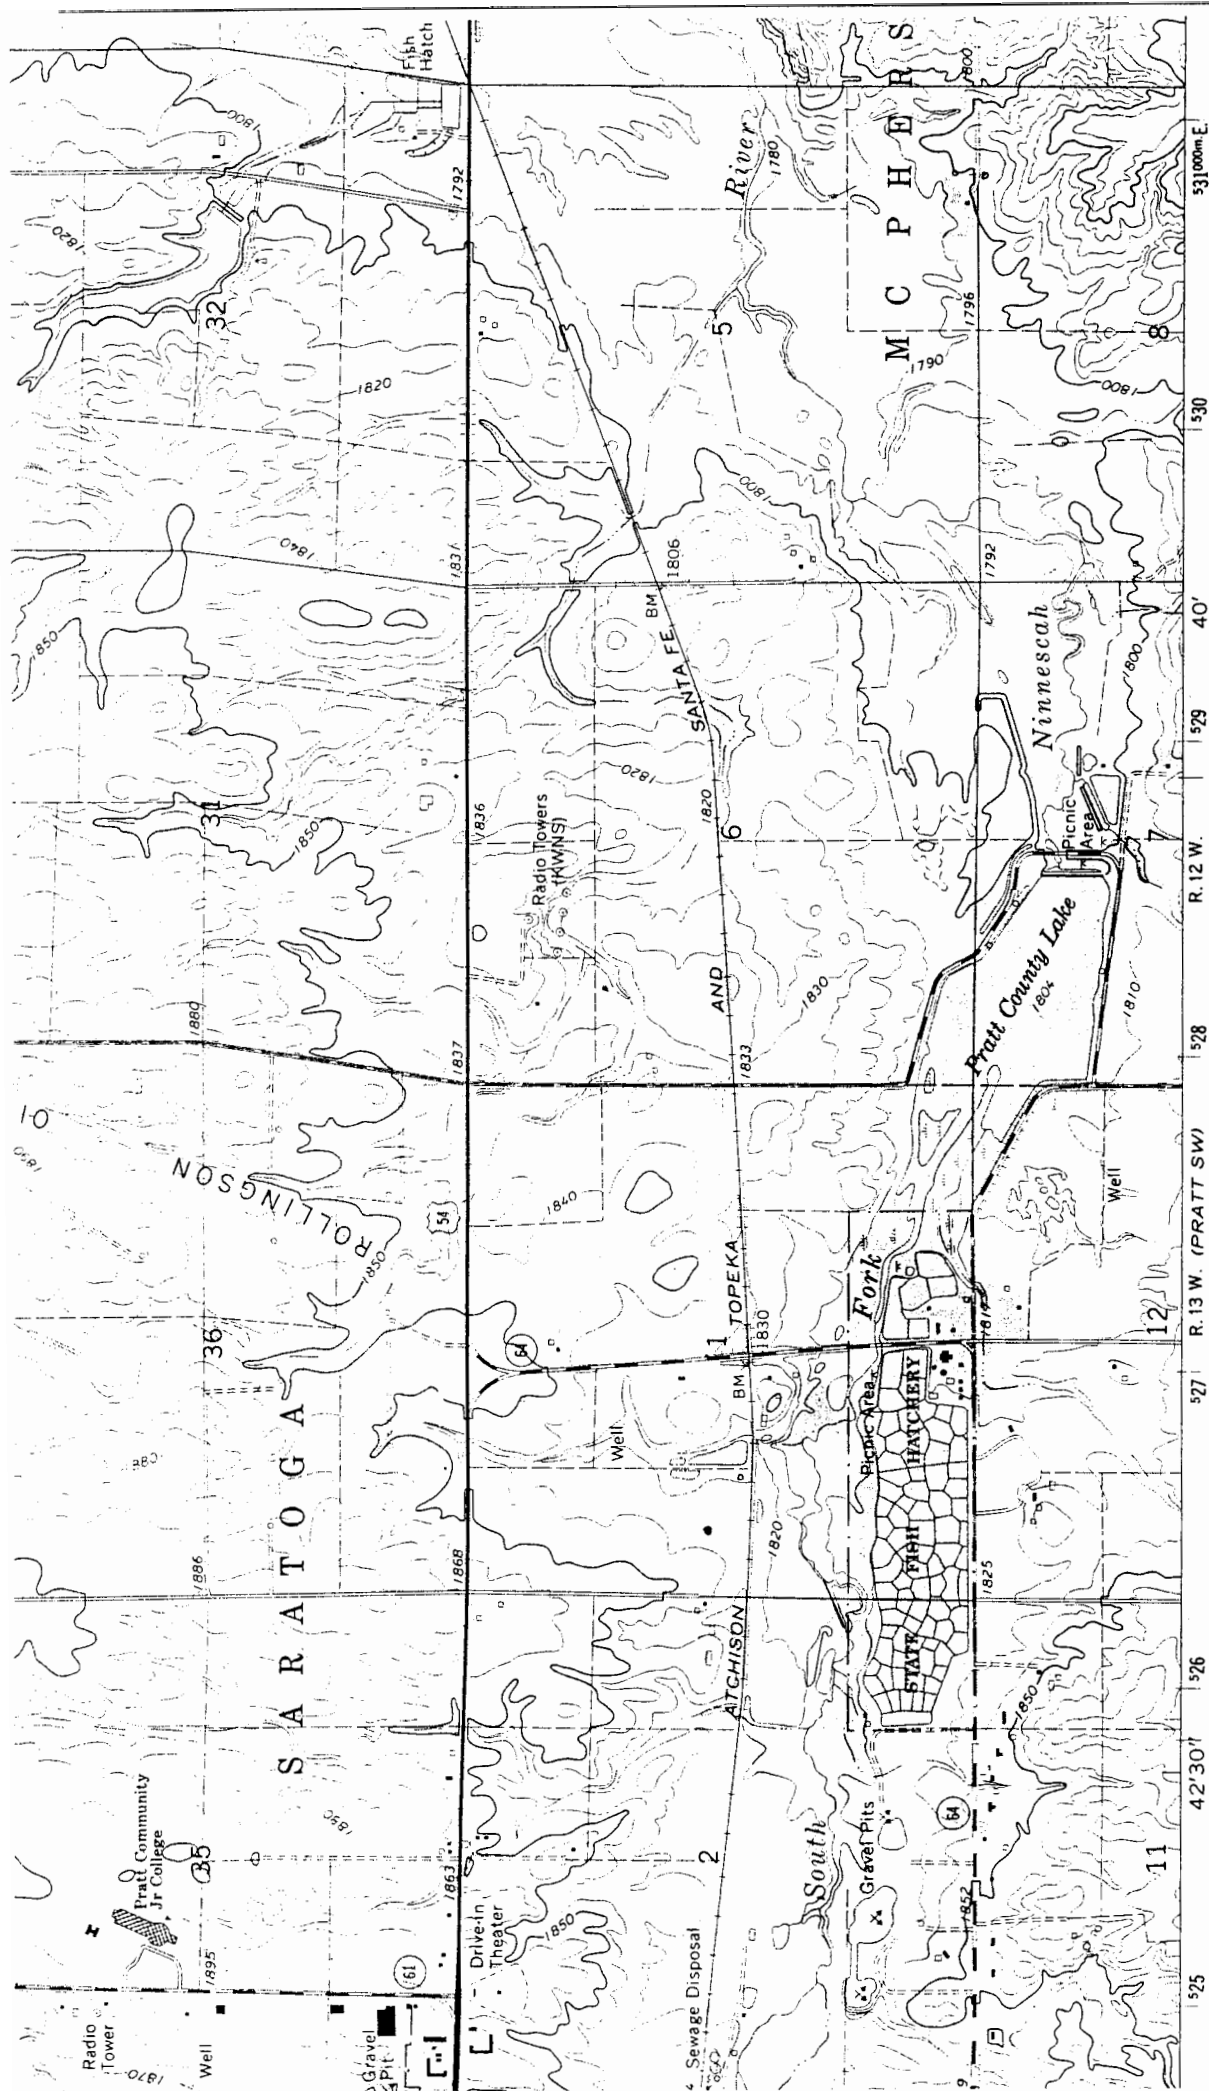

He Me

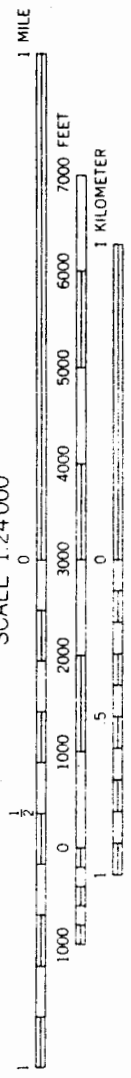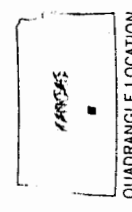

CONTOUR INTERVAL 10 FEET  
DATUM IS MEAN SEA LEVEL

## PRATT Quadrangle


10 AND 1968 MAGNETIC NORTH  
VARIATION AT CENTER OF SHEET

THIS MAP COMPIES WITH NATIONAL MAP ACCURACY STANDARDS

FOR SALE BY U. S. GEOLOGICAL SURVEY, DENVER, COLORADO 80225. OR WASHINGTON, D. C. 20242

SITE NUMBER : 42 CBA  
SITE LOCATION : SE SW 1/4  
LEGAL LOCATION : 1-28-13W  
COUNTY : PRATT

LANDOWNER: VERNON HILLARD  
ADDRESS : RT. 1  
PRATT, KS  
PHONE NO.: (316)-672-6177

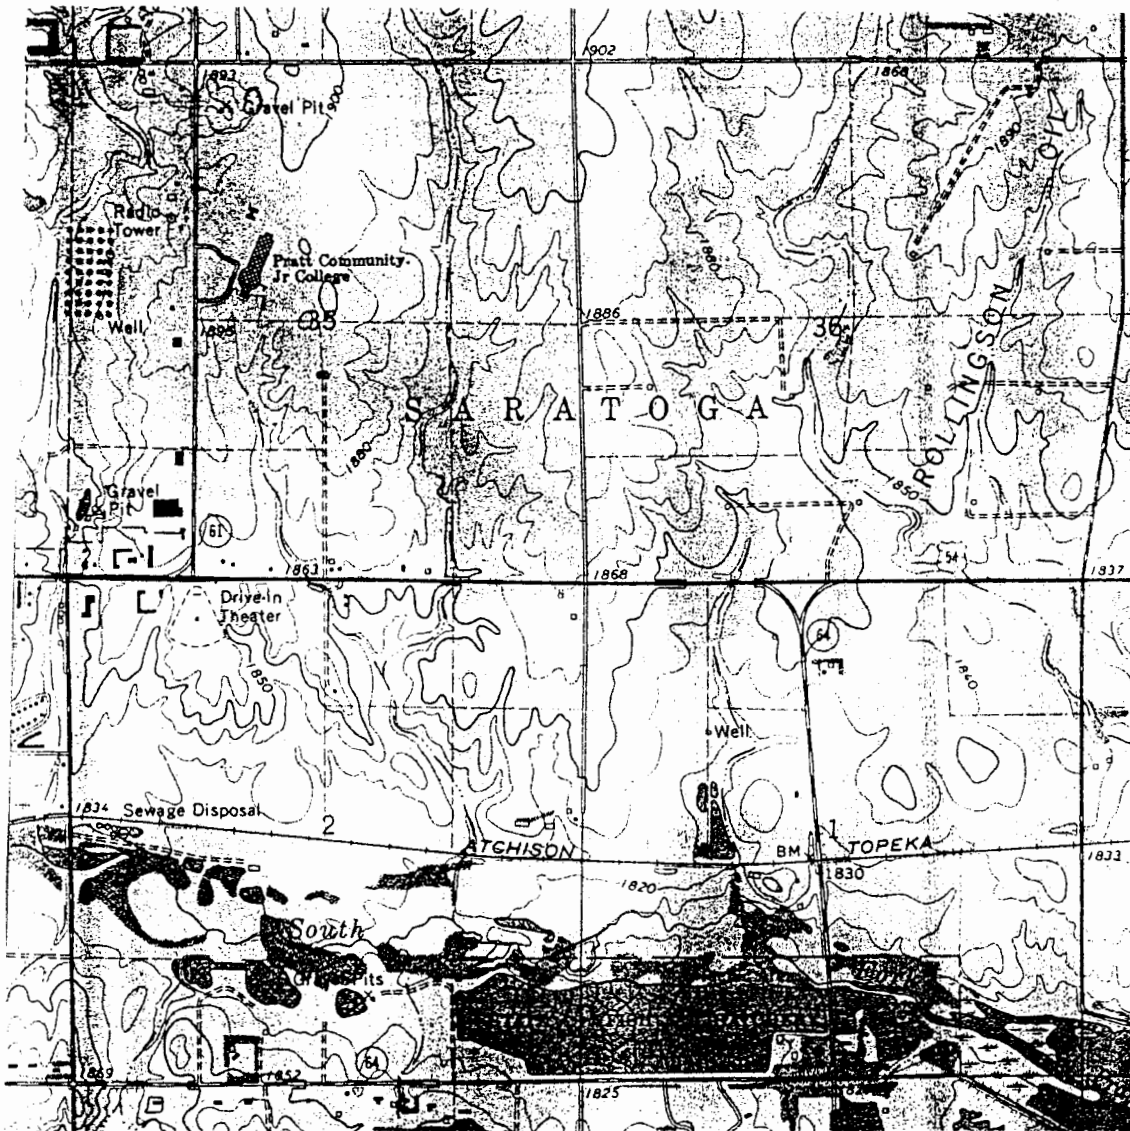

WELL LOCATION X