WATER WELL RECORD Form WWC-5 KSA 82a-1212

1 LOCATION OF WATER WELL: County: Pratt	Fraction: SE ¼ NE ¼ NE ¼	Section Number: 13	Township Number: T 28 S	Range Number: R 13 E (W)

Distance and direction from nearest town or city street address of well if located within city?

2 EAst 2½ South of Pratt

2 WATER WELL OWNER: Larry Crick

RR#, St. Address, Box # : RFD 1

City, State, ZIP Code : Pratt, Kansas

Board of Agriculture, Division of Water Resources Application Number:

3 LOCATE WELL'S LOCATION WITH AN "X" IN SECTION BOX:

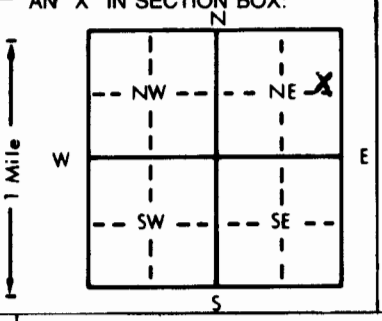

4 DEPTH OF COMPLETED WELL 98 ft. ELEVATION: Hill

Depth(s) Groundwater Encountered 1. 63 ft. 2. ft. 3. ft.

WELL'S STATIC WATER LEVEL 63 ft. below land surface measured on mo/day/yr 11-10-82

Pump test data: Well water was ft. after hours pumping gpm

Est. Yield 80 gpm: Well water was ft. after hours pumping gpm

Bore Hole Diameter 10 in. to 98 ft., and in. to ft.

WELL WATER TO BE USED AS: 1 Domestic 2 Irrigation 3 Feedlot 4 Industrial 5 Public water supply 6 Oil field water supply 7 Lawn and garden only 8 Air conditioning 9 Dewatering 10 Observation well 11 Injection well 12 Other (Specify below)

Was a chemical/bacteriological sample submitted to Department? Yes ..... No X; If yes, mo/day/yr sample was submitted

Water Well Disinfected? Yes X No

5 TYPE OF BLANK CASING USED: 1 Steel 2 PVC 3 RMP (SR) 4 ABS 5 Wrought iron 6 Asbestos-Cement 7 Fiberglass 8 Concrete tile 9 Other (specify below)

CASING JOINTS: Glued X Clamped Welded Threaded

Blank casing diameter 5 in. to 88 ft., Dia in. to ft., Dia in. to ft.

Casing height above land surface 16 in., weight 160 lbs./ft. Wall thickness or gauge No. SDR 26

TYPE OF SCREEN OR PERFORATION MATERIAL: 1 Steel 2 Brass 3 Stainless steel 4 Galvanized steel 5 Fiberglass 6 Concrete tile 7 PVC 8 RMP (SR) 9 ABS 10 Asbestos-cement 11 Other (specify) 12 None used (open hole)

SCREEN OR PERFORATION OPENINGS ARE: 1 Continuous slot 2 Louvered shutter 3 Mill slot 4 Key punched 5 Gauzed wrapped 6 Wire wrapped 7 Torch cut 8 Saw cut 9 Drilled holes 10 Other (specify) 11 None (open hole)

SCREEN-PERFORATED INTERVALS: From 88 ft. to 98 ft., From ft. to ft.
From ft. to ft., From ft. to ft.

GRAVEL PACK INTERVALS: From 68 ft. to 98 ft., From ft. to ft.
From ft. to ft., From ft. to ft.

6 GROUT MATERIAL: 1 Neat cement 2 Cement grout 3 Bentonite 4 Other

Grout Intervals: From 5 ft. to 15 ft., From ft. to ft., From ft. to ft.

What is the nearest source of possible contamination: 1 Septic tank 2 Sewer lines 3 Watertight sewer lines 4 Lateral lines 5 Cess pool 6 Seepage pit 7 Pit privy 8 Sewage lagoon 9 Feedyard 10 Livestock pens 11 Fuel storage 12 Fertilizer storage 13 Insecticide storage 14 Abandoned water well 15 Oil well/Gas well 16 Other (specify below)

Direction from well? EAst How many feet? 100

FROM	TO	LITHOLOGIC LOG		FROM	TO	LITHOLOGIC LOG
0	4	earth				
4	34	hard brown clay	01			
34	45	gyp & brown clay	36+01			
45	57	fine sand	07			
57	75	hard gyp rock & gyp clay	36			
75	80	fine sand	07			
80	98	coarse sand & gravel	17			

7 CONTRACTOR'S OR LANDOWNER'S CERTIFICATION: This water well was (1) constructed, (2) reconstructed, or (3) plugged under my jurisdiction and was completed on (mo/day/year) ~~11-10-82~~ 2-20-83 and this record is true to the best of my knowledge and belief. Kansas Water Well Contractor's License No. 103 This Water Well Record was completed on (mo/day/yr) ~~12-19-82~~ 3-20-83 under the business name of Hank Bruse Water Well Service by (signature) Henry Bruse

INSTRUCTIONS: Use typewriter or ball point pen, *PLEASE PRESS FIRMLY* and *PRINT* clearly. Please fill in blanks, underline or circle the correct answers. Send top three copies to Kansas Department of Health and Environment, Division of Environment, Environmental Geology Section, Topeka, KS 66620. Send one to WATER WELL OWNER and retain one for your records.

OFFICE USE ONLY T 28 R 13 E (W) SEC. 13 SE ¼ NE ¼ NE ¼

map JUL 2 1 47