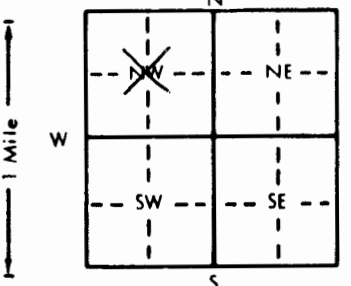


1 LOCATION OF WATER WELL:		Fraction	Section Number	Township Number	Range Number
County: Pratt		$\frac{1}{4}$ E 1/2 1/4 NW	15	T 28 S	R 13 EW
Distance and direction from nearest town or city street address of well if located within city? 1 mile east, 1.7 miles south of Pratt, Kansas					
2 WATER WELL OWNER:		Pratt County			
RR#, St. Address, Box # :		300 S. Ninnescah			
City, State, ZIP Code		Pratt, Ks.			
3 LOCATE WELL'S LOCATION WITH AN "X" IN SECTION BOX:		4 DEPTH OF COMPLETED WELL: 90 ft. ELEVATION: NA			
		Depth(s) Groundwater Encountered 1. ft. 2. ft. 3. ft.			
		WELL'S STATIC WATER LEVEL ft. below land surface measured on mo/day/yr			
		Pump test data: Well water was ft. after hours pumping gpm			
		Est. Yield gpm: Well water was ft. after hours pumping gpm			
Bore Hole Diameter: 8 in. to 90 ft. and in. to ft.		WELL WATER TO BE USED AS:			
1 Domestic		3 Feedlot	6 Oil field water supply	9 Dewatering	12 Other (Specify below)
2 Irrigation		4 Industrial	7 Lawn and garden only	10 Monitoring well	
Was a chemical/bacteriological sample submitted to Department? Yes.....No.. X; If yes, mo/day/yr sample was submitted					
Water Well Disinfected? Yes No X					
5 TYPE OF BLANK CASING USED:					
1 Steel		3 RMP (SR)	6 Asbestos-Cement	9 Other (specify below)	Welded
2 PVC		4 ABS	7 Fiberglass		Threaded X
Blank casing diameter 2 in. to 75 ft. Dia in. to ft. Dia in. to ft.					
Casing height above land surface 24 in., weight lbs./ft. Wall thickness or gauge No. sch. 40					
TYPE OF SCREEN OR PERFORATION MATERIAL:					
1 Steel		3 Stainless steel	5 Fiberglass	8 RMP (SR)	11 Other (specify)
2 Brass		4 Galvanized steel	6 Concrete tile	9 ABS	12 None used (open hole)
SCREEN OR PERFORATION OPENINGS ARE:					
1 Continuous slot		3 Mill slot .010	5 Gauzed wrapped	8 Saw cut	11 None (open hole)
2 Louvered shutter		4 Key punched	6 Wire wrapped	9 Drilled holes	
			7 Torch cut	10 Other (specify)	
SCREEN-PERFORATED INTERVALS: From 90 ft. to 75 ft. From ft. to ft.					
GRAVEL PACK INTERVALS: From 90 ft. to 70 ft. From ft. to ft.					
6 GROUT MATERIAL: 1 Neat cement 2 Cement grout 3 Bentonite 4 Other					
Grout Intervals: From 70 ft. to 66(ben) ft. From 66 ft. to 0(cem) ft. From ft. to ft.					
What is the nearest source of possible contamination:					
1 Septic tank		4 Lateral lines	7 Pit privy	10 Livestock pens	14 Abandoned water well
2 Sewer lines		5 Cess pool	8 Sewage lagoon	11 Fuel storage	15 Oil well/Gas well
3 Watertight sewer lines		6 Seepage pit	9 Feedyard	12 Fertilizer storage	16 Other (specify below)
				13 Insecticide storage	landfill
Direction from well? How many feet?					
FROM	TO	LITHOLOGIC LOG	FROM	TO	PLUGGING INTERVALS
0	4'	clay, sandy, red			
4'	9'	clay, silty, dark brown			
9	12	sand, silty, fine to medium			
12	16	clay, sandy, reddish brown			
16	19	clay, silty, red, sandy			
19	20	clay, sandy, red			
20	21	caliche, white			
21	26	sand, red, silty, fine to medium			
26	41	sand, silty, red, fine to coarse, clay lenses			
41	42	sand, medium to coarse, wet			
42	67	clay, silty, red, sandy			
67	90	sand, red, silty, fine to medium			
MW1					
7 CONTRACTOR'S OR LANDOWNER'S CERTIFICATION: This water well was 1 constructed, (2) reconstructed, or (3) plugged under my jurisdiction and was completed on (mo/day/year) 12-14-93 and this record is true to the best of my knowledge and belief. Kansas Water Well Contractor's License No. 527 This Water Well Record was completed on (mo/day/yr) 01-27-94 under the business name of GeoCore Services, Inc. by (signature) <i>Sal Robt</i>					
INSTRUCTIONS: Use typewriter or ball point pen. PLEASE PRESS FIRMLY and PRINT clearly. Please fill in blanks, underline or circle the correct answers. Send top three copies to Kansas Department of Health and Environment, Bureau of Water, Topeka, Kansas 66620-0001. Telephone: 913-296-5545. Send one to WATER WELL OWNER and retain one for your records.					