

**WATER WELL RECORD Form WWC-5**

Division of Water Resources App. No.


30,121

Well ID

Original Record  Correction  Change in Well Use

**1 LOCATION OF WATER WELL:** County: Pratt Fraction 1/4 NW 1/4 NE 1/4 SW 1/4 Section Number 19 Township Number T 28 S Range Number R 13  E  W

**2 WELL OWNER:** Last Name: Lemon, McCoy & Jennings First:  Street or Rural Address where well is located (if unknown, distance and direction from nearest town or intersection): If at owner's address, check here:   
 Business: Lemon, McCoy & Jennings Address: First National Bank Bldg, Ste 200 2 3/4 South, 2 West of Pratt  
 Address: P O Box 987 City: Pratt State: KS ZIP: 67124

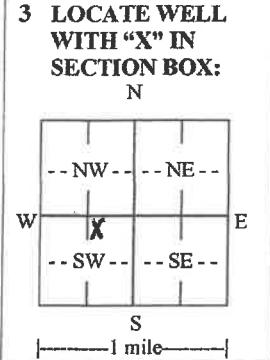

**4 DEPTH OF COMPLETED WELL:** 180 ft.  
 Depth(s) Groundwater Encountered: 1)  ft.  
 2)  ft. 3)  ft., or 4)  Dry Well  
 WELL'S STATIC WATER LEVEL: 97 ft.  
 below land surface, measured on (mo-day-yr) 3-1-18  
 above land surface, measured on (mo-day-yr)   
 Pump test data: Well water was  ft. after  hours pumping  gpm  
 Well water was  ft. after  hours pumping  gpm  
 Estimated Yield: 1463 gpm  
 Bore Hole Diameter: 30 in. to 180 ft. and  in. to  ft.

**5 Latitude:**  (decimal degrees)  
**Longitude:**  (decimal degrees)  
 Horizontal Datum:  WGS 84  NAD 83  NAD 27  
 Source for Latitude/Longitude:  
 GPS (unit make/model: ) (WAAS enabled?  Yes  No)  
 Land Survey  Topographic Map  
 Online Mapper:   
**6 Elevation:**  ft.  Ground Level  TOC  
 Source:  Land Survey  GPS  Topographic Map  
 Other

**7 WELL WATER TO BE USED AS:**

1. Domestic:  Household  Lawn & Garden  Livestock  
 2.  Irrigation  
 3.  Feedlot  
 4.  Industrial  
 5.  Public Water Supply: well ID   
 6.  Dewatering: how many wells?   
 7.  Aquifer Recharge: well ID   
 8.  Monitoring: well ID   
 9. Environmental Remediation: well ID   
 Air Sparge  Soil Vapor Extraction  
 Recovery  Injection  
 10.  Oil Field Water Supply: lease   
 11. Test Hole: well ID   
 Cased  Uncased  Geotechnical  
 12. Geothermal: how many bores?   
 a) Closed Loop  Horizontal  Vertical  
 b) Open Loop  Surface Discharge  Inj. of Water  
 13.  Other (specify):

Was a chemical/bacteriological sample submitted to KDHE?  Yes  No If yes, date sample was submitted:   
 Water well disinfected?  Yes  No

**8 TYPE OF CASING USED:**  Steel  PVC  Other  CASING JOINTS:  Glued  Clamped  Welded  Threaded  
 Casing diameter 16 in. to 180 ft., Diameter  in. to  ft., Diameter  in. to  ft.  
 Casing height above land surface 18 in. Weight Sch. 40 lbs./ft. Wall thickness or gauge No.

TYPE OF SCREEN OR PERFORATION MATERIAL:  
 Steel  Stainless Steel  Fiberglass  PVC  Other (Specify)   
 Brass  Galvanized Steel  Concrete tile  None used (open hole)

SCREEN OR PERFORATION OPENINGS ARE:  
 Continuous Slot  Mill Slot  Gauze Wrapped  Torch Cut  Drilled Holes  Other (Specify)   
 Louvered Shutter  Key Punched  Wire Wrapped  Saw Cut  None (Open Hole)

SCREEN-PERFORATED INTERVALS: From 180 ft. to 120 ft., From  ft. to  ft., From  ft. to  ft.  
 GRAVEL PACK INTERVALS: From 180 ft. to 20 ft., From  ft. to  ft., From  ft. to  ft.

**9 GROUT MATERIAL:**  Neat cement  Cement grout  Bentonite  Other   
 Grout Intervals: From  ft. to  ft., From 20 ft. to 0 ft., From  ft. to  ft.

Nearest source of possible contamination:  
 Septic Tank  Lateral Lines  Pit Privy  Livestock Pens  Insecticide Storage  
 Sewer Lines  Cess Pool  Sewage Lagoon  Fuel Storage  Abandoned Water Well  
 Watertight Sewer Lines  Seepage Pit  Feedyard  Fertilizer Storage  Oil Well/Gas Well  
 Other (Specify) None  
 Direction from well?  Distance from well?  ft.

10 FROM	TO	LITHOLOGIC LOG	FROM	TO	LITHO. LOG (cont.) or PLUGGING INTERVALS
0	3	Sandy top soil	160	174	Sand & gravel- small med clean coarse
3	35	Tan clay, brown clay w/ caliche			tight
35	66	Sand & gravel- small med clean coarse	174	180	Gritty tan clay w/ very little small gravel
		loose			
66	85	White tan clay, caliche, & soft cemented sand			
85	120	Sand & gravel- small med clean coarse			Notes:
		tight			
120	160	Sand & gravel- med to large clean coarse			

**11 CONTRACTOR'S OR LANDOWNER'S CERTIFICATION:** This water well was  constructed,  reconstructed, or  plugged under my jurisdiction and was completed on (mo-day-year) 3-23-18 and this record is true to the best of my knowledge and belief. Kansas Water Well Contractor's License No. 134 This Water Well Record was completed on (mo-day-year) 4-24-18 under the business name of Rosencrantz- Bemis Ent Inc Signature Erica A. Bemis