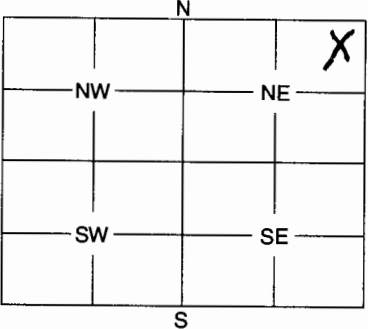


1 LOCATION OF WATER WELL: Fraction Section Number Township Number Range Number
 County: PRATT $\frac{1}{4}$ NE $\frac{1}{4}$ NE $\frac{1}{4}$ NE 15 28 13 EW

Distance and direction from nearest town or city street address of well if located within city?
2 miles South of Pratt on Hwy 281 To SE 20th St 1 mile East To SE 10th Ave 1/8 South West To well

2 WATER WELL OWNER: VERLAN ELLIOTT
 RR #, St. Address, Box #: 20083 SE 10th Ave Board of Agriculture, Division of Water Resources
 City, State, ZIP Code: PRATT, KS 67124 Application Number: _____

3 MARK WELL'S LOCATION WITH AN "X" IN SECTION BOX:

 4 DEPTH OF WELL 92 ft.
 WELL'S STATIC WATER LEVEL 73 ft.
 WELL WAS USED AS:
 1 Domestic 5 Public Water Supply 9 Dewatering
 2 Irrigation 6 Oil Field Water Supply 10 Monitoring Well
 3 Feedlot 7 Domestic (Lawn & Garden) 11 Injection Well
 4 Industrial 8 Air Conditioning 12 Other _____
 Was a chemical / bacteriological sample submitted to Department? Yes _____ No
 If yes, mo/day/yr sample was submitted _____
 Water Well Disinfected: Yes No _____

5 TYPE OF BLANK CASING USED:
 1 Steel 3 RMP (SR) 5 Wrought 7 Fiberglass 9 Other (Specify below)
 2 PVC 4 ABS 6 Asbestos-Cement 8 Concrete Tile _____
 Blank casing diameter 6 in. Was casing pulled? Yes _____ No If yes, how much _____
 Casing height above or below land surface 48 in.

6 GROUT PLUG MATERIAL: 1 Neat cement 2 Cement grout 3 Bentonite 4 Other _____
 Grout Plug Intervals: From 92 ft. to 71 ft., From 20 ft. to 4 ft., From _____ to _____ ft.
 What is the nearest source of possible contamination:
 1 Septic tank 6 Seepage pit 11 Fuel storage 16 Other (specify below) _____
 2 Sewer lines 7 Pit privy 12 Fertilizer storage _____
 3 Watertight sewer lines 8 Sewage lagoon 13 Insecticide storage _____
 4 Lateral lines 9 Feedyard 14 Abandoned water well _____
 5 Cess pool 10 Livestock pens 15 Oil well/Gas well _____
 Direction from well? South west How many feet? 100

FROM	TO	PLUGGING MATERIALS
92	71	Hole Plug Bentonite
71	20	Sand
20	4	Hole Plug Bentonite
4	0	Natural Top Soil & Clay

7 CONTRACTOR'S OF LANDOWNER'S CERTIFICATION: This water well was plugged under my jurisdiction and was completed on (mo/day/year) 10-18-18 and this record is true to the best of my knowledge and belief. Kansas Water Well Contractor's License No. 672 This Water Well Record was completed on (mo/day/year) 10-26-18 under the business name of Crowdis Water Well Svc.
 by (signature) [Signature]

INSTRUCTIONS: Use typewriter or ball point pen. Please press firmly and print clearly. Please fill in blanks, underline or circle the correct answers. Send top three copies to Kansas Department of Health and Environment, Bureau of Water, Geology Section, 1000 SW Jackson St., Ste. 420, Topeka, Kansas 66612-1367. Telephone: 785/296-5522. Send one to Water Well Owner and retain one for your records.