

**WATER WELL RECORD Form WWC-5**


Division of Water Resources App. No.

Well ID

Original Record  Correction  Change in Well Use

**1 LOCATION OF WATER WELL:** County: PRATT Fraction: 1/4 SE 1/4 NE 1/4 NW 1/4 Section Number: 8 Township Number: T 28 S Range Number: R 13 E  W

**2 WELL OWNER:** Last Name: GOERTZ First: Justin Street or Rural Address where well is located (if unknown, distance and direction from nearest town or intersection): If at owner's address, check here:   
 Business: 320 N. Howard ST. IN PRATT, 1/4 mile south of 10th ST  
 Address: PRATT State: KS ZIP: 67124 on West River Road west to well  
 City: PRATT

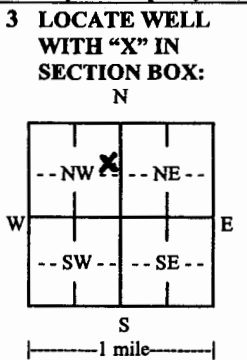

**4 DEPTH OF COMPLETED WELL:** 100 ft.  
 Depth(s) Groundwater Encountered: 1) 100 ft.  
 2) 7.6 ft. 3) 9-14-2020 ft.  Dry Well  
**WELL'S STATIC WATER LEVEL:** 7.6 ft.  
 below land surface, measured on (mo-day-yr) 9-14-2020  
 above land surface, measured on (mo-day-yr) 9-14-2020  

**5 Latitude:** ..... (decimal degrees)  
**Longitude:** ..... (decimal degrees)  
**Horizontal Datum:**  WGS 84  NAD 83  NAD 27  
**Source for Latitude/Longitude:**  
 GPS (unit make/model: .....)  
 (WAAS enabled?  Yes  No)  
 Land Survey  Topographic Map  
 Online Mapper: .....

**6 Elevation:** ..... ft.  Ground Level  TOC  
**Source:**  Land Survey  GPS  Topographic Map  
 Other .....

**7 WELL WATER TO BE USED AS:**

1. Domestic:  Household  Lawn & Garden  Livestock  
 2.  Irrigation  
 3.  Feedlot  
 4.  Industrial  
 5.  Public Water Supply: well ID .....

6.  Dewatering: how many wells? .....

7.  Aquifer Recharge: well ID .....

8.  Monitoring: well ID .....

9. Environmental Remediation: well ID .....

Air Sparge  Soil Vapor Extraction  
 Recovery  Injection

10.  Oil Field Water Supply: lease .....

11. Test Hole: well ID .....

Cased  Uncased  Geotechnical

12. Geothermal: how many bores? .....

a) Closed Loop  Horizontal  Vertical  
 b) Open Loop  Surface Discharge  Inj. of Water

13.  Other (specify): .....

**Was a chemical/bacteriological sample submitted to KDHE?**  Yes  No If yes, date sample was submitted: .....

Water well disinfected?  Yes  No

**8 TYPE OF CASING USED:**  Steel  PVC  Other ..... CASING JOINTS:  Glued  Clamped  Welded  Threaded  
 Casing diameter 5 in. to 80 ft., Diameter 80 in. to ..... ft., Diameter ..... in. to ..... ft.  
 Casing height above land surface 12 in. Weight SDR 26 lbs./ft. Wall thickness or gauge No. ....

**TYPE OF SCREEN OR PERFORATION MATERIAL:**  
 Steel  Stainless Steel  Fiberglass  PVC  Other (Specify) .....  
 Brass  Galvanized Steel  Concrete tile  None used (open hole)

**SCREEN OR PERFORATION OPENINGS ARE:**  
 Continuous Slot  Mill Slot  Gauze Wrapped  Torch Cut  Drilled Holes  Other (Specify) .....  
 Louvered Shutter  Key Punched  Wire Wrapped  Saw Cut  None (Open Hole)

**SCREEN-PERFORATED INTERVALS:** From 80 ft. to 100 ft., From ..... ft. to ..... ft., From ..... ft. to ..... ft.  
**GRAVEL PACK INTERVALS:** From 100 ft. to 20 ft., From ..... ft. to ..... ft., From ..... ft. to ..... ft.

**9 GROUT MATERIAL:**  Neat cement  Cement grout  Bentonite  Other .....  
 Grout Intervals: From 20 ft. to 0 ft., From ..... ft. to ..... ft., From ..... ft. to ..... ft.

**Nearest source of possible contamination:**  
 Septic Tank  Lateral Lines  Pit Privy  Livestock Pens  Insecticide Storage  
 Sewer Lines  Cess Pool  Sewage Lagoon  Fuel Storage  Abandoned Water Well  
 Watertight Sewer Lines  Seepage Pit  Feedyard  Fertilizer Storage  Oil Well/Gas Well  
 Other (Specify) .....

Direction from well? 999 Distance from well? 999 ft.

10 FROM	TO	LITHOLOGIC LOG	FROM	TO	LITHO. LOG (cont.) or PLUGGING INTERVALS
0	5	Bra Sand Top Soil			
5	15	Tan Clay			
15	20	Bra Sandy Clay			
20	45	Tan Fine Sand			
45	50	Coarse Sand			
50	105	Fine Tan Sand			
105	110	Bra/white Clay			
Notes: .....					

**11 CONTRACTOR'S OR LANDOWNER'S CERTIFICATION:** This water well was  constructed,  reconstructed, or  plugged under my jurisdiction and was completed on (mo-day-year) 9-14-2020 and this record is true to the best of my knowledge and belief. Kansas Water Well Contractor's License No. 672 This Water Well Record was completed on (mo-day-year) 9-14-2020 under the business name of Crowd's Water Well Serv. Signature [Signature]