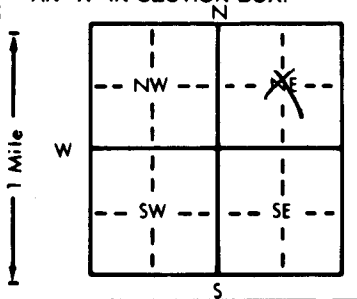


1 LOCATION OF WATER WELL: County: <u>Pratt</u>		Fraction <u>1/4 N/C 1/4 NE 1/4</u>	Section Number <u>34</u>	Township Number <u>T 28 S</u>	Range Number <u>R 14 E/W</u>	
Distance and direction from nearest town or city street address of well if located within city? <u>3 3/4 south 3 1/8 east of Cullison, Ks.</u>	
2 WATER WELL OWNER: <u>Merle Rose</u> RR#, St. Address, Box # : <u>120199 West 1st.</u> City, State, ZIP Code : <u>Haviland, Ks. 67059</u> Board of Agriculture, Division of Water Resources Application Number:	
3 LOCATE WELL'S LOCATION WITH AN "X" IN SECTION BOX: 		4 DEPTH OF COMPLETED WELL... <u>245</u> ft. ELEVATION: Depth(s) Groundwater Encountered 1. ft. 2. ft. 3. ft. WELL'S STATIC WATER LEVEL... <u>85</u> ft. below land surface measured on mo/day/yr <u>5-25-99</u> Pump test data: Well water was ft. after hours pumping gpm Est. Yield <u>NA</u> gpm: Well water was ft. after hours pumping gpm Bore Hole Diameter <u>7</u> in. to <u>245</u> ft., and in. to ft. WELL WATER TO BE USED AS: 5 Public water supply 8 Air conditioning 11 Injection well 1 Domestic 3 Feedlot 6 Oil field water supply 9 Dewatering 12 Other (Specify below) 2 Irrigation 4 Industrial 7 Lawn and garden only 10 Monitoring well <u>test hole</u> Was a chemical/bacteriological sample submitted to Department? Yes <u>X</u> No If yes, mo/day/yr sample was submitted <u>5-25-99</u> Water Well Disinfected? Yes No <u>X</u>	
5 TYPE OF BLANK CASING USED: 1 Steel 3 RMP (SR) 5 Wrought iron 8 Concrete tile CASING JOINTS: Glued <u>X</u> Clamped 2 PVC 4 ABS 6 Asbestos-Cement 9 Other (specify below) Welded 7 Fiberglass Threaded Blank casing diameter <u>3</u> in. to <u>236</u> ft., Dia in. to ft., Dia in. to ft. Casing height above land surface <u>2'</u> in., weight <u>sch 80</u> lbs./ft. Wall thickness or gauge No. TYPE OF SCREEN OR PERFORATION MATERIAL: 1 Steel 3 Stainless steel 5 Fiberglass 7 PVC 10 Asbestos-cement 2 Brass 4 Galvanized steel 6 Concrete tile 8 RMP (SR) 11 Other (specify) 9 ABS 12 None used (open hole) SCREEN OR PERFORATION OPENINGS ARE: 1 Continuous slot 3 Mill slot 5 Gauzed wrapped 8 Saw cut 11 None (open hole) 2 Louvered shutter 4 Key punched 6 Wire wrapped 9 Drilled holes 7 Torch cut 10 Other (specify) SCREEN-PERFORATED INTERVALS: From <u>236</u> ft. to <u>241</u> ft., From ft. to ft. GRAVEL PACK INTERVALS: From <u>245</u> ft. to <u>230</u> ft., From ft. to ft.	
6 GROUT MATERIAL: 1 Neat cement 2 Cement grout 3 Bentonite 4 Other <u>hole plug 230-227, 49' to 0</u> Grout Intervals: From <u>227</u> ft. to <u>49</u> ft., From ft. to ft., From ft. to <u>49</u> ft. to <u>0</u> ft. What is the nearest source of possible contamination: 1 Septic tank 4 Lateral lines 7 Pit privy 10 Livestock pens 14 Abandoned water well 2 Sewer lines 5 Cess pool 8 Sewage lagoon 11 Fuel storage 15 Oil well/Gas well 3 Watertight sewer lines 6 Seepage pit 9 Feedyard 12 Fertilizer storage 16 Other (specify below) 13 Insecticide storage Direction from well? <u>north west</u> How many feet? <u>1/4 mile</u>	
<table border="1"><thead><tr><th>FROM</th><th>TO</th><th>LITHOLOGIC LOG</th><th>FROM</th><th>TO</th><th>PLUGGING INTERVALS</th></tr></thead><tbody><tr><td>0</td><td>3</td><td>Top soil</td><td>226</td><td>231</td><td>Sand and gravel loose, medium</td></tr><tr><td>3</td><td>29</td><td>Tough brown clay</td><td>231</td><td>236</td><td>Tough brown clay with caliche</td></tr><tr><td>29</td><td>47</td><td>Brown and white clay</td><td>236</td><td>241</td><td>Sand and gravel loose clean</td></tr><tr><td>47</td><td>70</td><td>Sand and gravel clean coarse loose</td><td>241</td><td>245</td><td>Red bed</td></tr><tr><td>70</td><td>78</td><td>Brown clay</td><td></td><td></td><td></td></tr><tr><td>78</td><td>81</td><td>Sandy brown clay</td><td></td><td></td><td></td></tr><tr><td>81</td><td>88</td><td>Sand and gravel</td><td></td><td></td><td></td></tr><tr><td>88</td><td>91</td><td>Tough yellow brown blue gray clay</td><td></td><td></td><td></td></tr><tr><td>91</td><td>116 1/2</td><td>Sand and gravel clean coarse loose</td><td></td><td></td><td></td></tr><tr><td>116 1/2</td><td>123</td><td>Brown clay</td><td></td><td></td><td></td></tr><tr><td>123</td><td>142</td><td>Sand and gravel clean coarse loose</td><td></td><td></td><td></td></tr><tr><td>142</td><td>156</td><td>Sandy yellow brown clay</td><td></td><td></td><td></td></tr><tr><td>156</td><td>188</td><td>Sand and gravel clean coarse loose</td><td></td><td></td><td></td></tr><tr><td>188</td><td>192</td><td>Sand and gravel with clay mix</td><td></td><td></td><td></td></tr><tr><td>192</td><td>226</td><td>Redish brown gray white clay</td><td></td><td></td><td></td></tr>
7 CONTRACTOR'S OR LANDOWNER'S CERTIFICATION: This water well was (1) <u>constructed</u> , (2) reconstructed, or (3) plugged under my jurisdiction and was completed on (mo/day/year) <u>5-26-99</u> and this record is true to the best of my knowledge and belief. Kansas Water Well Contractor's License No. <u>134</u> This Water Well Record was completed on (mo/day/yr) <u>5-27-99</u> under the business name of <u>Rosencrantz-Bemis</u> by (signature)	