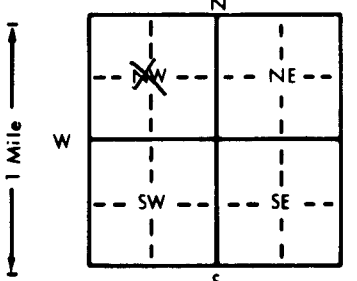


1 LOCATION OF WATER WELL: County: Pratt		Fraction $\frac{1}{4}$ N/C $\frac{1}{4}$ NW $\frac{1}{4}$	Section Number 35	Township Number T 28 S	Range Number R 14 <del>E</del> W						
Distance and direction from nearest town or city street address of well if located within city? 3 3/4 south 3 3/4 east of Cullison, Ks.											
2 WATER WELL OWNER: Merle Rose RR#, St. Address, Box # : 120199 West 1st. City, State, ZIP Code : Haviland, Ks. 67059 Board of Agriculture, Division of Water Resources Application Number:											
3 LOCATE WELL'S LOCATION WITH AN "X" IN SECTION BOX: 		4 DEPTH OF COMPLETED WELL: 230 ft. ELEVATION: Depth(s) Groundwater Encountered 1. ft. 2. ft. 3. ft. WELL'S STATIC WATER LEVEL 80 1/2 ft. below land surface measured on mo/day/yr 5-25-99 Pump test data: Well water was ft. after hours pumping gpm Est. Yield NA gpm: Well water was ft. after hours pumping gpm Bore Hole Diameter 7 in. to 230 ft., and in. to ft. WELL WATER TO BE USED AS: 5 Public water supply 8 Air conditioning 11 Injection well 1 Domestic 3 Feedlot 6 Oil field water supply 9 Dewatering 12 Other (Specify below) 2 Irrigation 4 Industrial 7 Lawn and garden only 10 Monitoring well test hole Was a chemical/bacteriological sample submitted to Department? Yes X No: If yes, mo/day/yr sample was submitted 5-25-99 Water Well Disinfected? Yes No X									
5 TYPE OF BLANK CASING USED: 1 Steel 3 RMP (SR) 5 Wrought iron 8 Concrete tile CASING JOINTS: Glued X Clamped 2 PVC 4 ABS 6 Asbestos-Cement 9 Other (specify below) Welded 7 Fiberglass Threaded Blank casing diameter 3 in. to 217 ft., Dia in. to ft., Dia in. to ft. Casing height above land surface 2' in., weight sch. 80 lbs./ft. Wall thickness or gauge No. TYPE OF SCREEN OR PERFORATION MATERIAL: 1 Steel 3 Stainless steel 5 Fiberglass 7 PVC 10 Asbestos-cement 2 Brass 4 Galvanized steel 6 Concrete tile 8 RMP (SR) 11 Other (specify) 9 ABS 12 None used (open hole) SCREEN OR PERFORATION OPENINGS ARE: 1 Continuous slot 3 Mill slot 5 Gauzed wrapped 8 Saw cut 11 None (open hole) 2 Louvered shutter 4 Key punched 6 Wire wrapped 9 Drilled holes 7 Torch cut 10 Other (specify) SCREEN-PERFORATED INTERVALS: From 222 ft. to 217 ft., From ft. to ft. From ft. to ft., From ft. to ft. GRAVEL PACK INTERVALS: From 230 ft. to 210 ft., From ft. to ft. From ft. to ft., From ft. to ft.											
6 GROUT MATERIAL: 1 Neat cement 2 Cement grout 3 Bentonite 4 Other hole plug 212-210, 20' 40' Grout Intervals: From 210 ft. to 20 ft., From ft. to ft. to 20' 40' ft. What is the nearest source of possible contamination: 1 Septic tank 4 Lateral lines 7 Pit privy 10 Livestock pens 14 Abandoned water well 2 Sewer lines 5 Cess pool 8 Sewage lagoon 11 Fuel storage 15 Oil well/Gas well 3 Watertight sewer lines 6 Seepage pit 9 Feedyard 12 Fertilizer storage 16 Other (specify below) 13 Insecticide storage Direction from well? North east How many feet? 1/4 mile											
FROM		TO		LITHOLOGIC LOG		FROM		TO		PLUGGING INTERVALS	
0		3		Top soil		128		183		Sand and gravel clean	
3		7		Brown clay		183		212		Brown redish brown white clay	
7		18		Brown and white clay		212		222		Sand and gravel medium loose clean	
18		21		Sand and gravel clay mixed		222		230		Red bed	
21		26		Brown and white sandy clay							
26		31		Sand and gravel							
31		32		Brown clay							
32		46		Sand and gravel loose coarse							
46		50		Tough brown clay							
50		56		Redish brown tough clay							
56		60		Brown and white clay							
60		99		Sand and gravel coarse loose							
99		102		Brown clay							
102		124		Sand and gravel clean coarse loose							
124		128		Brown clay							
7 CONTRACTOR'S OR LANDOWNER'S CERTIFICATION: This water well was (1) constructed, (2) reconstructed, or (3) plugged under my jurisdiction and was completed on (mo/day/year) 5-26-99 and this record is true to the best of my knowledge and belief. Kansas Water Well Contractor's License No. 134 This Water Well Record was completed on (mo/day/yr) 5-27-99 under the business name of Rosencrantz-Bemis by (signature) Fredia Dodson											