

| | | | | |
|---------------------------|-----------------------------|----------------|----------------------|-----------------------|
| 1 LOCATION OF WATER WELL: | Fraction | Section Number | Township Number | Range Number |
| County: <u>Pratt</u> | <u>NN 1/4 SE 1/4 SW 1/4</u> | <u>06</u> | T <u>28</u> <u>S</u> | R <u>14</u> <u>EW</u> |

Distance and direction from nearest town or city street address of well if located within city?

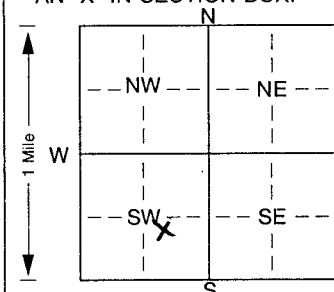
80492 W. Highway 54 Pratt KS 671242 WATER WELL OWNER: Collingwood Grain CullisonRR#, St. Address, Box # : 80492 W. Highway 54City, State, ZIP Code : Pratt KS 67124

Board of Agriculture, Division of Water Resources

Application Number:

3 LOCATE WELL'S LOCATION WITH 4 DEPTH OF COMPLETED WELL: 84' ft. ELEVATION: 2038.16

AN "X" IN SECTION BOX:


WELL WATER TO BE USED AS: 5 Public water supply 8 Air conditioning 11 Injection well

1 Domestic 3 Feedlot 6 Oil field water supply 9 Dewatering 12 Other (Specify below)

2 Irrigation 4 Industrial 7 Domestic (lawn & garden) 10 Monitoring well

Was a chemical/bacteriological sample submitted to Department? Yes. No X; If yes, mo/day/yr sample was submitted

Water Well Disinfected? Yes No X

5 TYPE OF CASING USED: 5 Wrought iron 8 Concrete tile CASING JOINTS: Glued. Clamped.

1 Steel 3 RMP (SR) 6 Asbestos-Cement 9 Other (specify below) Welded Threaded. PVC

2 PVC 4 ABS 7 Fiberglass


TYPE OF SCREEN OR PERFORATION MATERIAL:

1 Steel 3 Stainless steel 5 Fiberglass 8 RMP (SR) 10 Asbestos-cement

2 Brass 4 Galvanized steel 6 Concrete tile 9 ABS 11 Other (specify)

12 None used (open hole)

SCREEN OR PERFORATION OPENINGS ARE:

1 Continuous slot 3 Mill slot 5 Gauzed wrapped 8 Saw cut 11 None (open hole)

2 Louvered shutter 4 Key punched 6 Wire wrapped 9 Drilled holes

7 Torch cut 10 Other (specify) 64 ft. to 84 ft.




What is the nearest source of possible contamination:

1 Septic tank 4 Lateral lines 7 Pit privy 10 Livestock pens 14 Abandoned water well

2 Sewer lines 5 Cess pool 8 Sewage lagoon 11 Fuel storage 15 Oil well/Gas well

3 Watertight sewer lines 6 Seepage pit 9 Feedyard 12 Fertilizer storage 16 Other (specify below) 16 LOST SITE

13 Insecticide storage

Direction from well?

How many feet?

| FROM | TO | LITHOLOGIC LOG | FROM | TO | PLUGGING INTERVALS |
|------|-----|---|------|-----|--|
| 0' | 1' | Crushed Rock | | | Sorted, No odor (SP) |
| 1' | 10' | Clay, brown, silty, slightly sandy, moderate | 72' | 84' | Clay, green grey, silty, very sandy, low density, mod. |
| 10' | 29' | Clay, Red brown, silty, dry low plasticity (CL) | | | Plasticity, moist, No odor (CL) |
| 29' | 35' | Sand, brown, silty <15% clay, well sorted dry (SW) | | | |
| 35' | 53' | Sand, Red brown, fine to very fine, dry, silty (SR) | | | |
| 35' | 53' | Clay, Red brown, very sandy low plasticity, moderate density, dry, No odor (CL) | | | |
| 53' | 73' | Sand, Red brown, fine to very fine, dry silty, well- | | | |

7 CONTRACTOR'S OR LANDOWNER'S CERTIFICATION: This water well was (1) constructed, (2) reconstructed, or (3) plugged under my jurisdiction and was completed on (mo/day/year) 10/9/01 and this record is true to the best of my knowledge and belief. KansasWater Well Contractor's Licence No. 594 This Water Well Record was completed on (mo/day/yr) 10/30/01under the business name of Coranco Great Plains by (signature) Denise Sprague