WATER WELL RECORD Form WWC-5 KSA 82a-1212 ID No. _____

1 LOCATION OF WATER WELL: County: Pratt | Fraction: SW ¼ NW ¼ SW ¼ | Section Number: 9 | Township Number: T 28 S | Range Number: R 14 E/W

Distance and direction from nearest town or city street address of well if located within city?
Cullison 2 East 3/4 South

2 WATER WELL OWNER: Gary Rose
RR#, St. Address, Box # :
City, State, ZIP Code : Cullison KS
Board of Agriculture, Division of Water Resources Application Number:

3 LOCATE WELL'S LOCATION WITH AN "X" IN SECTION BOX:

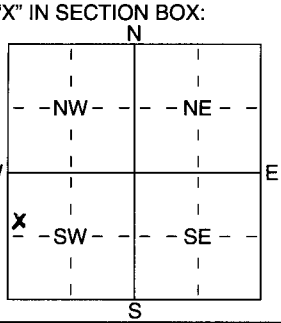


4 DEPTH OF COMPLETED WELL 143 ft. ELEVATION:
Depth(s) Groundwater Encountered 1 95 ft. 2 ft. 3 ft.
WELL'S STATIC WATER LEVEL 95 ft. below land surface measured on mo/day/yr
Pump test data: Well water was ft. after hours pumping gpm
Est. Yield gpm: Well water was ft. after hours pumping gpm
WELL WATER TO BE USED AS: 5 Public water supply 8 Air conditioning 11 Injection well
(1) Domestic 3 Feedlot 6 Oil field water supply 9 Dewatering 12 Other (Specify below)
2 Irrigation 4 Industrial 7 Domestic (lawn & garden) 10 Monitoring well

Was a chemical/bacteriological sample submitted to Department? Yes No ; If yes, mo/day/yrs sample was submitted
Water Well Disinfected? (Yes) No

5 TYPE OF BLANK CASING USED: 5 Wrought iron 8 Concrete tile CASING JOINTS: Glued Clamped
1 Steel 3 RMP (SR) 6 Asbestos-Cement 9 Other (specify below) Welded
(2) PVC 4 ABS 7 Fiberglass Threaded
Blank casing diameter 5 in. to 123 ft., Dia in. to ft., Dia in. to ft.
Casing height above land surface 24 in., weight SDR 21 lbs./ft. Wall thickness or guage No.

TYPE OF SCREEN OR PERFORATION MATERIAL:
(1) PVC .032 10 Asbestos-Cement
1 Steel 3 Stainless Steel 5 Fiberglass 8 RMP (SR) 11 Other (Specify)
2 Brass 4 Galvanized Steel 6 Concrete tile 9 ABS 12 None used (open hole)

SCREEN OR PERFORATION OPENINGS ARE:
1 Continuous slot (3) Mill slot 5 Guazed wrapped 8 Saw cut 11 None (open hole)
2 Louvered shutter 4 Key punched 6 Wire wrapped 9 Drilled holes
7 Torch cut 10 Other (specify) ft.

SCREEN-PERFORATED INTERVALS: From 123 ft. to 143 ft., From ft. to ft.
From ft. to ft., From ft. to ft.
GRAVEL PACK INTERVALS: From 26 ft. to 95 ft., From 101 ft. to 143 ft.
From ft. to ft., From ft. to ft.

6 GROUT MATERIAL: 1 Neat cement 2 Cement grout (3) Bentonite 4 Other
Grout Intervals: From 5 ft. to 26 ft., From 95 ft. to 101 ft., From ft. to ft.

What is the nearest source of possible contamination:
1 Septic tank 4 Lateral lines 7 Pit privy 10 Livestock pens 14 Abandoned water well
2 Sewer lines 5 Cess pool (8) Sewage lagoon 11 Fuel storage 15 Oil well/Gas well
3 Watertight sewer lines 6 Seepage pit 9 Feedyard 12 Fertilizer storage 16 Other (specify below)
13 Insecticide storage
Direction from well? South East How many feet? 200

| FROM | TO | LITHOLOGIC LOG | FROM | TO | PLUGGING INTERVALS |
|---|---|---|---|---|---|
| 0 | 16 | Top Soil + Brown Clay Firm | | | |
| 16 | 32 | Brown Clay Little Cliche | | | |
| 32 | 60 | Brown Clay Little Sdy Clay | | | |
| 60 | 65 | Sand with Little Clay | | | |
| 65 | 82 | Sand Medium | | | |
| 82 | 93 | Clay | | | |
| 93 | 96 | Sand | | | |
| 96 | 98 | Clay | | | |
| 98 | 101 | Brown Clay | | | |
| 101 | 119 | Sand Medium | | | |
| 119 | 129 | Clay | | | |
| 129 | 147 | Sand Medium to Coarse | | | |
| | | | | | |
| | | | | | |

7 CONTRACTOR'S OR LANDOWNER'S CERTIFICATION: This water well was (1) constructed, (2) reconstructed, or (3) plugged under my jurisdiction and was completed on (mo/day/year) 8-11-05 and this record is true to the best of my knowledge and belief. Kansas Water Well Contractor's Licence No 637 This Water Well Record was completed on (mo/day/yr) 8-12-05 under the business name of CLT Inc. by (signature) Clyde

INSTRUCTIONS: Use typewriter or ball point pen. *PLEASE PRESS FIRMLY* and *PRINT* clearly. Please fill in blanks, underline or circle the correct answers. Send top three copies to Kansas Department of Health and Environment, Bureau of Water, Geology Section, 1000 SW Jackson St., Suite 420, Topeka, Kansas 66612-1367. Telephone 785-296-5522. Send one to WATER WELL OWNER and retain one for your records. Fee of $5.00 for each constructed well.