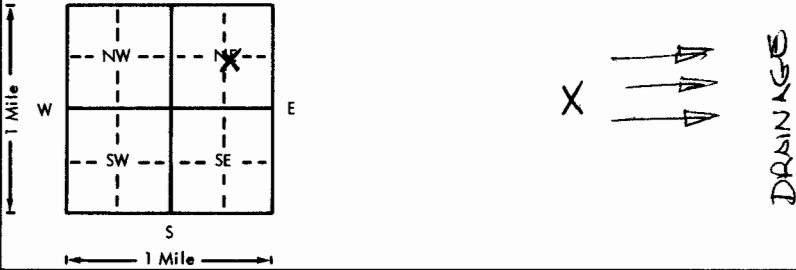


USE TYPEWRITER OR BALL
POINT PEN-PRESS FIRMLY,
PRINT CLEARLY.

WATER WELL RECORD
KSA 82a-1201-1215

Kansas Department of Health and
Environment-Division of Environment
(Water well Contractors)
Topeka, Kansas 66620

| | | | | | | |
|--|--|---|---|--|--|--------------|
| 1. Location of well: | | County PRATT | Fraction NW 1/4 SE 1/4 NE 1/4 | Section number 30 | Township number T 28 S R 14 W E/W | Range number |
| 2. Distance and direction from nearest town or city: 3 S 3/4 E 1/4 S Street address of well location if in city: OF CULLISON, KS | | | 3. Owner of well: JOEL BRUBAKER R.R. or street: City, state, zip code: SAWYER, KANSAS | | | |
| 4. Locate with "X" in section below: N W E S 1 Mile 1 Mile | | Sketch map:  | | 6. Bore hole dia. 30 in. Completion date 4 JAN 77 Well depth 195 ft. | | |
| 5. Type and color of material | | From | To | 7. Cable tool <input type="checkbox"/> Rotary <input type="checkbox"/> Driven <input type="checkbox"/> Dug <input type="checkbox"/> Hollow rod <input type="checkbox"/> Jetted <input type="checkbox"/> Bored <input checked="" type="checkbox"/> Reverse rotary | | |
| SOIL | | 0 | 2 | 8. Use: <input type="checkbox"/> Domestic <input type="checkbox"/> Public supply <input type="checkbox"/> Industry <input checked="" type="checkbox"/> Irrigation <input type="checkbox"/> Air conditioning <input type="checkbox"/> Stock <input type="checkbox"/> Lawn <input type="checkbox"/> Oil field water <input type="checkbox"/> Other | | |
| CLAY, TAN & WHITE | | 2 | 30 | 9. Casing: Material STL Height: Above or below Threaded <input type="checkbox"/> Welded <input checked="" type="checkbox"/> Surface 12 in. RMP <input type="checkbox"/> PVC <input type="checkbox"/> Weight <input type="checkbox"/> lbs./ft. Dia. 16 in. to 135 ft. depth; Wall Thickness: inches or Dia. <input type="checkbox"/> in. to <input type="checkbox"/> ft. depth; gage No. 188 | | |
| SAND, FINE TO COARSE | | 30 | 32 | 10. Screen: Manufacturer's name WA BROWN Type FREE FLO Dia. 16 Slot/gauze 1/8 Length 60 Set between 135 ft. and 195 ft. ft. and <input type="checkbox"/> ft. Gravel pack? Yes Size range of material 1/4 - 1/8 | | |
| CALICHE, HARD | | 32 | 34 | 11. Static water level: <input type="checkbox"/> mo./day/yr. 77 ft. below land surface Date 4 JAN 77 | | |
| CLAY, YELLOW | | 34 | 76 | 12. Pumping level below land surfaces: 92 ft. after 1 1/2 hrs. pumping 805 g.p.m. 103 ft. after 1 hrs. pumping 1200 g.p.m. Estimated maximum yield 1600 g.p.m. | | |
| SAND, FINE TO COARSE & MED TO COARSE GRAVEL | | 76 | 195 | 13. Water sample submitted: <input type="checkbox"/> mo./day/yr. <input type="checkbox"/> Yes <input checked="" type="checkbox"/> No Date <input type="checkbox"/> | | |
| CLAY, TAN | | 195 | 204 | 14. Well head completion: <input type="checkbox"/> Pitless adapter 12 inches above grade | | |
| SAND, FINE TO COARSE | | 204 | 210 | 15. Well grouted? Yes With: <input type="checkbox"/> Neat cement <input checked="" type="checkbox"/> Bentonite <input type="checkbox"/> Concrete Depth: From 0 ft. to 10 ft. | | |
| CLAY, GREEN | | 210 | 220 | 16. Nearest source of possible contamination: ft. <input type="checkbox"/> Direction <input type="checkbox"/> Type NONE Well disinfected upon completion? <input checked="" type="checkbox"/> Yes <input type="checkbox"/> No | | |
| SHALE, RED | | 220 | 230 | 17. Pump: <input type="checkbox"/> Not installed Manufacturer's name FLOWAY Model number 12 DOM HP <input type="checkbox"/> Volts <input type="checkbox"/> Length of drop pipe 120 ft. capacity 800 g.p.m. Type: <input type="checkbox"/> Submersible <input checked="" type="checkbox"/> Turbine <input type="checkbox"/> Jet <input type="checkbox"/> Reciprocating <input type="checkbox"/> Centrifugal <input type="checkbox"/> Other | | |
| (Use a second sheet if needed) | | | | | | |
| 18. Elevation: 2017 Topography: <input type="checkbox"/> Hill <input type="checkbox"/> Slope <input checked="" type="checkbox"/> Upland <input type="checkbox"/> Valley | | 19. Remarks: CONCRETE SLAB WAS INSTALLED AT SURFACE BY OWNER 276/2 28 14 30 MAX | | | 20. Water well contractor's certification: This well was drilled under my jurisdiction and this report is true to the best of my knowledge and belief. CENTRAL WELL & PUMP 325 Business name License No. Address 121 S. TAYLOR PRATT Signed PHILANOMUEL Date 2 FEB 77 Authorized representative | |

Forward the white, blue and pink copies to the Department of Health and Environment

Form WWC-5