


**WATER WELL RECORD Form WWC-5**

Original Record  Correction  Change in Well Use

Division of Water Resources App. No.   Well ID  

**1 LOCATION OF WATER WELL:** County: Pratt Fraction: 1/4 NW 1/4 NW 1/4 SW 1/4 Section Number: 21 Township Number: T 28 S Range Number: R 14 E W

**2 WELL OWNER:** Last Name: Johnsrud First: Gregg Street or Rural Address where well is located (if unknown, distance and direction from nearest town or intersection): If at owner's address, check here:   
 Business:   Address: 30290 SW 70th Ave 7 miles west of Pratt on Hwy 54 to SE 70th Ave  
 Address:   City: Pratt State: Ks ZIP: 67124 3 miles South East to well

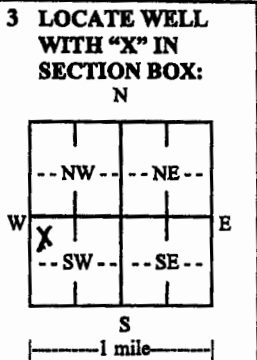

**4 DEPTH OF COMPLETED WELL:** 175 ft.  
 Depth(s) Groundwater Encountered: 1)   ft.  
 2)   ft. 3)   ft., or 4)  Dry Well  
 WELL'S STATIC WATER LEVEL: 74 ft.  
 below land surface, measured on (mo-day-yr)    
 above land surface, measured on (mo-day-yr) 11-6-17  
 Pump test data: Well water was   ft. after   hours pumping   gpm  
 Well water was   ft. after   hours pumping   gpm  
 Estimated Yield:   gpm  
 Bore Hole Diameter: 10 3/8 in. to 180 ft. and   in. to   ft.

**5 Latitude:**   (decimal degrees)  
**Longitude:**   (decimal degrees)  
 Horizontal Datum:  WGS 84  NAD 83  NAD 27  
 Source for Latitude/Longitude:  
 GPS (unit make/model:  ) (WAAS enabled?  Yes  No)  
 Land Survey  Topographic Map  
 Online Mapper:    
**6 Elevation:**   ft.  Ground Level  TOC  
 Source:  Land Survey  GPS  Topographic Map  
 Other:  

**7 WELL WATER TO BE USED AS:**

1. Domestic:  Household  Lawn & Garden  Livestock  
 2.  Irrigation  
 3.  Feedlot  
 4.  Industrial  
 5.  Public Water Supply: well ID    
 6.  Dewatering: how many wells?    
 7.  Aquifer Recharge: well ID    
 8.  Monitoring: well ID    
 9. Environmental Remediation: well ID    
 Air Sparge  Soil Vapor Extraction  
 Recovery  Injection  
 10.  Oil Field Water Supply: lease    
 11. Test Hole: well ID    
 Cased  Uncased  Geotechnical  
 12. Geothermal: how many bores?    
 a) Closed Loop  Horizontal  Vertical  
 b) Open Loop  Surface Discharge  Inj. of Water  
 13.  Other (specify):  

Was a chemical/bacteriological sample submitted to KDHE?  Yes  No If yes, date sample was submitted:    
 Water well disinfected?  Yes  No

**8 TYPE OF CASING USED:**  Steel  PVC  Other   CASING JOINTS:  Glued  Clamped  Welded  Threaded  
 Casing diameter 5 in. to 15.5 ft., Diameter   in. to   ft., Diameter   in. to   ft.  
 Casing height above land surface 24 in. Weight SDC 26 lbs./ft. Wall thickness or gauge No.    
**TYPE OF SCREEN OR PERFORATION MATERIAL:**  
 Steel  Stainless Steel  Fiberglass  PVC  Other (Specify)    
 Brass  Galvanized Steel  Concrete tile  None used (open hole)  
**SCREEN OR PERFORATION OPENINGS ARE:**  
 Continuous Slot  Mill Slot  Gauze Wrapped  Torch Cut  Drilled Holes  Other (Specify)    
 Louvered Shutter  Key Punched  Wire Wrapped  Saw Cut  None (Open Hole)  
**SCREEN-PERFORATED INTERVALS:** From 175 ft. to 155 ft., From   ft. to   ft., From   ft. to   ft.  
**GRAVEL PACK INTERVALS:** From 175 ft. to 20 ft., From   ft. to   ft., From   ft. to   ft.

**9 GROUT MATERIAL:**  Neat cement  Cement grout  Bentonite  Other    
 Grout Intervals: From 20 ft. to 0 ft., From   ft. to   ft., From   ft. to   ft.  
**Nearest source of possible contamination:**  
 Septic Tank  Lateral Lines  Pit Privy  Livestock Pens  Insecticide Storage  
 Sewer Lines  Cess Pool  Sewage Lagoon  Fuel Storage  Abandoned Water Well  
 Watertight Sewer Lines  Seepage Pit  Feedyard  Fertilizer Storage  Oil Well/Gas Well  
 Other (Specify)    
 Direction from well? 999 Distance from well? 999 ft.

10 FROM	TO	LITHOLOGIC LOG	FROM	TO	LITHO. LOG (cont.) or PLUGGING INTERVALS
0	5	DARK BRN TOP SOI	140	165	FINE TAN SAND
5	25	FINE TAN SAND	165	175	LARGE SAND & GRAVEL
25	30	TAN CLAY	175	180	RED CLAY
30	40	MED TO FINE SAND			
40	65	TAN SANDY CLAY			
65	105	FINE TAN SAND			
105	110	COARSE GRAVEL			
110	130	FINE TAN SAND			
130	140	LARGE GRAVEL			

**11 CONTRACTOR'S OR LANDOWNER'S CERTIFICATION:** This water well was  constructed,  reconstructed, or  plugged under my jurisdiction and was completed on (mo-day-year) 11-6-17 and this record is true to the best of my knowledge and belief. Kansas Water Well Contractor's License No. 675 This Water Well Record was completed on (mo-day-year) 12-12-17 under the business name of CANDIS WATER WELL SERV. Signature  

Mail 1 white copy along with a fee of \$5.00 for each constructed well to: Kansas Department of Health and Environment, Bureau of Water, GWTS Section, 1000 SW Jackson St., Suite 420, Topeka, Kansas 66612-1367. Mail one to Water Well Owner and retain one for your records. Telephone 785-296-5524.