WATER WELL RECORD Form WWC-5 KSA 82a-1212 ID No. _____

1 LOCATION OF WATER WELL:	Fraction	Section Number	Township Number	Range Number
County: Pratt	NC ¼ S½ ¼ SE ¼	32	T 28 S	R 15 E/W

Distance and direction from nearest town or city street address of well if located within city?
3½ North, 1 3/4 West of Springvale

2 WATER WELL OWNER: Vincent Oil Corp.
RR#, St. Address, Box # : 125 N. Market- Suite 1075
City, State, ZIP Code : Wichita, Ks. 67202

Board of Agriculture, Division of Water Resources
Application Number: 20030084

3 LOCATE WELL'S LOCATION WITH AN "X" IN SECTION BOX:

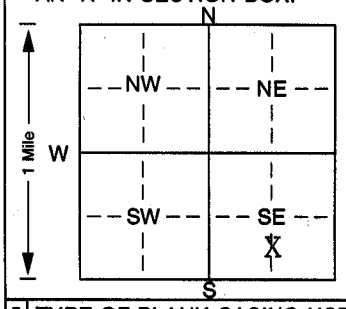

4 DEPTH OF COMPLETED WELL....114..... ft. ELEVATION:.....
Depth(s) Groundwater Encountered 1.....ft. 2.....ft. 3.....ft.
WELL'S STATIC WATER LEVEL..37.....ft. below land surface measured on mo/day/yr ...5-26-03.....
Pump test data: Well water was .....ft. after ..... hours pumping ..... gpm
Est. Yield ..N/A....gpm: Well water was .....ft. after ..... hours pumping ..... gpm
Bore Hole Diameter.....9..in. to ...114.....ft., and.....in. to .....ft.
WELL WATER TO BE USED AS: 5 Public water supply 8 Air conditioning 11 Injection well
1 Domestic 3 Feedlot 6 Oil field water supply 9 Dewatering 12 Other (Specify below)
2 Irrigation 4 Industrial 7 Domestic (lawn & garden) 10 Monitoring well .....
Was a chemical/bacteriological sample submitted to Department? Yes..... No. X ...; If yes, mo/day/yrs sample was submitted
Water Well Disinfected? Yes HTH No

5 TYPE OF BLANK CASING USED: 5 Wrought iron 8 Concrete tile CASING JOINTS: Glued...X..Clamped.....
1 Steel 3 RMP (SR) 6 Asbestos-Cement 9 Other (specify below) Welded.....
2 PVC 4 ABS 7 Fiberglass ..... Threaded.....
Blank casing diameter.....5.....in. to ....94.....ft., Dia .....in. to .....ft., Dia .....in. to .....ft.
Casing height above land surface.....24.....in., weight ...SDR-.26.....lbs./ft. Wall thickness or gauge No.....
TYPE OF SCREEN OR PERFORATION MATERIAL: 7 PVC 10 Asbestos-cement
1 Steel 3 Stainless steel 5 Fiberglass 8 RMP (SR) 11 Other (specify).....
2 Brass 4 Galvanized steel 6 Concrete tile 9 ABS 12 None used (open hole)
SCREEN OR PERFORATION OPENINGS ARE: 5 Gauzed wrapped 8 Saw cut 11 None (open hole)
1 Continuous slot 3 Mill slot 6 Wire wrapped 9 Drilled holes
2 Louvered shutter 4 Key punched 7 Torch cut 10 Other (specify).....ft.
SCREEN-PERFORATED INTERVALS: From....114..... ft. to ....94..... ft., From ..... ft. to..... ft.
From..... ft. to ..... ft., From ..... ft. to..... ft.
GRAVEL PACK INTERVALS: From....114..... ft. to ....20..... ft., From ..... ft. to..... ft.
From..... ft. to ..... ft., From ..... ft. to..... ft.

6 GROUT MATERIAL: 1 Neat cement 2 Cement grout 3 Bentonite 4 Other ....hole plug.....
Grout Intervals: From.....20.....ft. to ....0.....ft., From .....ft. to.....ft., From .....ft. to.....ft.
What is the nearest source of possible contamination: 10 Livestock pens 14 Abandoned water well
1 Septic tank 4 Lateral lines 7 Pit privy 11 Fuel storage 15 Oil well/Gas well
2 Sewer lines 5 Cess pool 8 Sewage lagoon 12 Fertilizer storage 16 Other (specify below)
3 Watertight sewer lines 6 Seepage pit 9 Feedyard 13 Insecticide storage ....None.....
Direction from well? How many feet?

FROM	TO	LITHOLOGIC LOG	FROM	TO	PLUGGING INTERVALS
0	4	Sandy top soil			
4	114	Sand & gravel coarse, loose			

7 CONTRACTOR'S OR LANDOWNER'S CERTIFICATION: This water well was (1) constructed, (2) reconstructed, or (3) plugged under my jurisdiction and was completed on (mo/day/year) .....5-26-03..... and this record is true to the best of my knowledge and belief. Kansas Water Well Contractor's Licence No....134..... This Water Well Record was completed on (mo/day/yr) ...5-29-03.....
under the business name of Rosencrantz- Bemis by (signature) [signature]

INSTRUCTIONS: Use typewriter or ball point pen. *PLEASE PRESS FIRMLY* and *PRINT* clearly. Please fill in blanks, underline or circle the correct answers. Send top three copies to Kansas Department of Health and Environment, Bureau of Water, Topeka, Kansas 66620-0001. Telephone 785-296-5524. Send one to WATER WELL OWNER and retain one for your records. Fee of $5.00 for each constructed well.