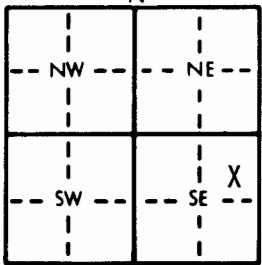
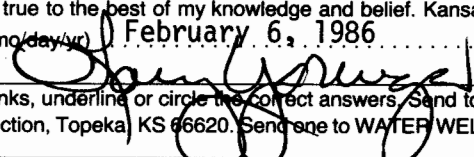


1 LOCATION OF WATER WELL: County: Pratt		Fraction C E 1/2 NE 1/4 SE 1/4	Section Number 24	Township Number T 28 S	Range Number R 15W E/W
Distance and direction from nearest town or city street address of well if located within city? 3.62 S -- 330' W of Cullison, Kansas					
2 WATER WELL OWNER: Mr. Eric Cowen RR#, St. Address, Box # : R. R. #2 City, State, ZIP Code : Pratt, KS 67124 Board of Agriculture, Division of Water Resources Application Number: Unknown COWEN #1					
3 LOCATE WELL'S LOCATION WITH AN "X" IN SECTION BOX: 		4 DEPTH OF COMPLETED WELL: 160 ft. ELEVATION: Depth(s) Groundwater Encountered 1. 89 ft. 2. 89 ft. 3. 89 ft. WELL'S STATIC WATER LEVEL 89 ft. below land surface measured on mo/day/yr 1-20-86 Pump test data: Well water was 80 gpm. Well water was 80 gpm. hours pumping 80 gpm. Bore Hole Diameter 10 in. to 160 ft. and 160 in. to 160 ft. WELL WATER TO BE USED AS: 1 Domestic 3 Feedlot <u>6 Oil field water supply</u> 8 Air conditioning 11 Injection well 2 Irrigation 4 Industrial 7 Lawn and garden only 9 Dewatering 12 Other (Specify below) Was a chemical/bacteriological sample submitted to Department? Yes.....No...XX..... If yes, mo/day/yr sample was submitted Water Well Disinfected? Yes XX No			
5 TYPE OF BLANK CASING USED: 1 Steel 3 RMP (SR) 5 Wrought iron 8 Concrete tile CASING JOINTS: Glued XX Clamped 2 PVC 4 ABS 6 Asbestos-Cement 9 Other (specify below) Welded 7 Fiberglass Threaded Blank casing diameter 5 in. to 140 ft. Dia 5 in. to 140 ft. Dia 5 in. to 140 ft. Dia Casing height above land surface 12 in., weight 2.34 lbs./ft. Wall thickness or gauge No. 214 TYPE OF SCREEN OR PERFORATION MATERIAL: 1 Steel 3 Stainless steel 5 Fiberglass 7 PVC 10 Asbestos-cement 2 Brass 4 Galvanized steel 6 Concrete tile 8 RMP (SR) 11 Other (specify) 12 None used (open hole) SCREEN OR PERFORATION OPENINGS ARE: 1 Continuous slot 3 Mill slot 5 Gauzed wrapped 8 Saw cut 11 None (open hole) 2 Louvered shutter 4 Key punched 6 Wire wrapped 9 Drilled holes 7 Torch cut 10 Other (specify) SCREEN-PERFORATED INTERVALS: From 140 ft. to 160 ft. From 140 ft. to 160 ft. From 140 ft. to 160 ft. GRAVEL PACK INTERVALS: From 10 ft. to 160 ft. From 10 ft. to 160 ft. From 10 ft. to 160 ft.					
6 GROUT MATERIAL: 1 Neat cement 2 Cement grout 3 Bentonite 4 Other Grout Intervals: From 140 ft. to 160 ft. From 140 ft. to 160 ft. From 140 ft. to 160 ft. What is the nearest source of possible contamination: 1 Septic tank 4 Lateral lines 7 Pit privy 10 Livestock pens 14 Abandoned water well 2 Sewer lines 5 Cess pool 8 Sewage lagoon 11 Fuel storage 15 Oil well/Gas well 3 Watertight sewer lines 6 Seepage pit 9 Feedyard 12 Fertilizer storage 16 Other (specify below) 13 Insecticide storage Direction from well? How many feet? FROM TO LITHOLOGIC LOG FROM TO LITHOLOGIC LOG -160 -3 Cement grout, plugged with 15 sxs cement -3 GL Native Soil					
7 CONTRACTOR'S OR LANDOWNER'S CERTIFICATION: This water well was (1) constructed, (2) reconstructed, or (3) plugged under my jurisdiction and was completed on (mo/day/year) January 29, 1986 and this record is true to the best of my knowledge and belief. Kansas Water Well Contractor's License No. H-30, Inc. This Water Well Record was completed on (mo/day/yr) February 6, 1986 under the business name of H-30, Inc. by (signature)  INSTRUCTIONS: Use typewriter or ball point pen, PLEASE PRESS FIRMLY and PRINT clearly. Please fill in blanks, underline or circle the correct answers. Send top three copies to Kansas Department of Health and Environment, Division of Environment, Environmental Geology Section, Topeka, KS 66620. Send one to WATER WELL OWNER and retain one for your records.					