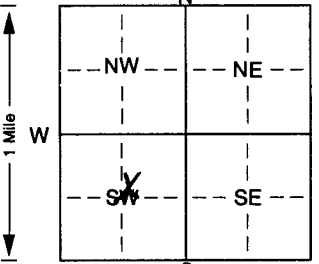


1 LOCATION OF WATER WELL: Fraction SW 1/4 NE 1/4 SW 1/4 Section Number 31 Township Number T 28 S Range Number R 16 E/W
 County: Kiowa

Distance and direction from nearest town or city street address of well if located within city?
4 South, 3/4 mile West of Haviland

2 WATER WELL OWNER: Pickrell Drilling Co.
 RR#, St. Address, Box #: Box 1303 Board of Agriculture, Division of Water Resources
 City, State, ZIP Code: Great Bend Kansas 67530 Application Number:

3 LOCATE WELL'S LOCATION WITH AN "X" IN SECTION BOX:

 4 DEPTH OF COMPLETED WELL: 140 ft. ELEVATION:
 Depth(s) Groundwater Encountered 1. 75 ft. 2. 100 ft. 3. 110 ft.
 WELL'S STATIC WATER LEVEL 75 ft. below land surface measured on mo/day/yr 4-10-2001
 Pump test data: Well water was 75 ft. after 1 hours pumping 100 gpm
 Est. Yield 100 gpm: Well water was 75 ft. after 1 hours pumping 100 gpm
 Bore Hole Diameter: 8 3/4 in. to 140 ft., and 140 in. to 140 ft.
 WELL WATER TO BE USED AS:
 5 Public water supply 8 Air conditioning 11 Injection well
 1 Domestic 3 Feedlot 6 Oil field water supply 9 Dewatering 12 Other (Specify below)
 2 Irrigation 4 Industrial 7 Domestic (lawn & garden) 10 Monitoring well
 Was a chemical/bacteriological sample submitted to Department? Yes X No X; if yes, mo/day/yr sample was submitted
 Water Well Disinfected? Yes X No

5 TYPE OF BLANK CASING USED:
 1 Steel 3 RMP (SR) 5 Wrought iron 8 Concrete tile CASING JOINTS: Glued X Clamped
 2 PVC 4 ABS 7 Fiberglass 9 Other (specify below) Welded
 Blank casing diameter 5 in. to 120 ft., Dia. 120 in. to 140 ft., Dia. 140 in. to 140 ft.
 Casing height above land surface 18 in., weight 50 lbs./ft. Wall thickness or gauge No. SM-26
 TYPE OF SCREEN OR PERFORATION MATERIAL:
 1 Steel 3 Stainless steel 5 Fiberglass 7 PVC 10 Asbestos-cement
 2 Brass 4 Galvanized steel 6 Concrete tile 8 RMP (SR) 11 Other (specify)
 9 ABS 12 None used (open hole)
 SCREEN OR PERFORATION OPENINGS ARE:
 1 Continuous slot 3 Mill slot 5 Gauzed wrapped 8 Saw cut 11 None (open hole)
 2 Louvered shutter 4 Key punched 6 Wire wrapped 9 Drilled holes
 7 Torch cut 10 Other (specify) 10 ft.
 SCREEN-PERFORATED INTERVALS: From 120 ft. to 140 ft., From 140 ft. to 140 ft.
 GRAVEL PACK INTERVALS: From 20 ft. to 140 ft., From 140 ft. to 140 ft.

6 GROUT MATERIAL: 1 Neat cement 2 Cement grout 3 Bentonite 4 Other
 Grout Intervals: From 0 ft. to 20 ft., From 20 ft. to 140 ft., From 140 ft. to 140 ft.
 What is the nearest source of possible contamination:
 1 Septic tank 4 Lateral lines 7 Pit privy 10 Livestock pens 14 Abandoned water well
 2 Sewer lines 5 Cess pool 8 Sewage lagoon 11 Fuel storage 15 Oil well/Gas well
 3 Watertight sewer lines 6 Seepage pit 9 Feedyard 12 Fertilizer storage 16 Other (specify below)
 13 Insecticide storage
 Direction from well? East How many feet? 1000

FROM	TO	LITHOLOGIC LOG	FROM	TO	PLUGGING INTERVALS
<u>0</u>	<u>38</u>	<u>Tan Clay</u>			
<u>38</u>	<u>140</u>	<u>Sand & Gravel</u>			

7 CONTRACTOR'S OR LANDOWNER'S CERTIFICATION: This water well was (1) constructed, (2) reconstructed, or (3) plugged under my jurisdiction and was completed on (mo/day/year) 4-10-2001 and this record is true to the best of my knowledge and belief. Kansas Water Well Contractor's Licence No. 653 This Water Well Record was completed on (mo/day/yr) 4-19-2001 under the business name of Dan Hays Water Well Service by (signature) Dan Hays