


LOCATION OF WATER WELL: County: <u>Kiowa</u>	Fraction <u>W 1/2 1/4 W 1/2 1/4 NE 1/4</u>	Section Number <u>1</u>	Township Number <u>T 28 S</u>	Range Number <u>R 16 E</u>
---	---	----------------------------	----------------------------------	-------------------------------

Distance and direction from nearest town or city street address of well if located within city?

1 north of Wellsford

WATER WELL OWNER: <u>Trust Peoples Bank</u>	<u>Mustang Drilling</u>
RR#, St. Address, Box #: <u>Pratt, Ks.</u>	<u>Box 1609</u>
City, State, ZIP Code:	<u>Great Bend, Ks.</u>
	Board of Agriculture, Division of Water Resources Application Number: <u>T83-696</u>

LOCATE WELL'S LOCATION WITH AN "X" IN SECTION BOX:

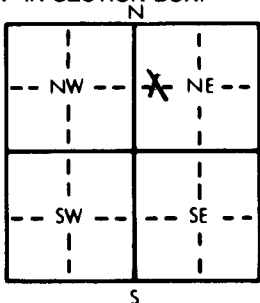

4 DEPTH OF COMPLETED WELL: 185 ft. ELEVATION: _____

Depth(s) Groundwater Encountered 1. 43 ft. 2. _____ ft. 3. _____ ft.

WELL'S STATIC WATER LEVEL 65 ft. below land surface measured on mo/day/yr 12-23-83

Pump test data: Well water was _____ ft. after _____ hours pumping _____ gpm

Est. Yield NA gpm: Well water was _____ ft. after _____ hours pumping _____ gpm

Bore Hole Diameter 1.0 in. to 1.85 ft., and _____ in. to _____ ft.

WELL WATER TO BE USED AS:

5 Public water supply	8 Air conditioning	11 Injection well
1 Domestic	3 Feedlot	6 Oil field water supply
2 Irrigation	4 Industrial	7 Lawn and garden only
		9 Dewatering
		10 Observation well
		12 Other (Specify below)

Was a chemical/bacteriological sample submitted to Department? Yes _____ No X _____; If yes, mo/day/yr sample was submitted _____

Water Well Disinfected? Yes HTH No _____

5 TYPE OF BLANK CASING USED:

1 Steel	3 RMP (SR)	5 Wrought iron	8 Concrete tile	CASING JOINTS: Glued <u>X</u> Clamped _____
2 PVC	4 ABS	6 Asbestos-Cement	9 Other (specify below)	Welded _____
		7 Fiberglass		Threaded _____

Blank casing diameter 5 in. to 14.5 ft., Dia _____ in. to _____ ft., Dia _____ in. to _____ ft.

Casing height above land surface 1.8 in., weight _____ lbs./ft. Wall thickness or gauge No. 2.58

TYPE OF SCREEN OR PERFORATION MATERIAL:

1 Steel	3 Stainless steel	5 Fiberglass	7 PVC	10 Asbestos-cement
2 Brass	4 Galvanized steel	6 Concrete tile	8 RMP (SR)	11 Other (specify)
			9 ABS	12 None used (open hole)

SCREEN OR PERFORATION OPENINGS ARE:

1 Continuous slot	3 Mill slot	5 Gauzed wrapped	8 Saw cut	11 None (open hole)
2 Louvered shutter	4 Key punched	6 Wire wrapped	9 Drilled holes	
		7 Torch cut	10 Other (specify)	

SCREEN-PERFORATED INTERVALS: From 145 ft. to 185 ft., From _____ ft. to _____ ft.

GRAVEL PACK INTERVALS: From 10 ft. to 185 ft., From _____ ft. to _____ ft.

6 GROUT MATERIAL: 1 Neat cement 2 Cement grout 3 Bentonite 4 Other _____

GROUT INTERVALS: From 0 ft. to 10 ft., From _____ ft. to _____ ft., From _____ ft. to _____ ft.

What is the nearest source of possible contamination:

1 Septic tank	4 Lateral lines	7 Pit privy	10 Livestock pens	14 Abandoned water well
2 Sewer lines	5 Cess pool	8 Sewage lagoon	11 Fuel storage	15 <u>Oil well/Gas well</u>
3 Watertight sewer lines	6 Seepage pit	9 Feedyard	12 Fertilizer storage	16 Other (specify below)
			13 Insecticide storage	

Direction from well? west How many feet? 80

FROM	TO	LITHOLOGIC LOG	FROM	TO	LITHOLOGIC LOG
0	3	Sandy top soil			
3	43	Tan clay			
43	82	Tan sandy clay			
82	168	Sand and gravel			
168	185	Tan sandy clay with streaks of medium sand			

7 CONTRACTOR'S OR LANDOWNER'S CERTIFICATION: This water well was (1) constructed, (2) reconstructed, or (3) plugged under my jurisdiction and was completed on (mo/day/year) 12-23-83 and this record is true to the best of my knowledge and belief. Kansas Water Well Contractor's License No. 134 This Water Well Record was completed on (mo/day/yr) 1-16-84

under the business name of Rosencrantz-Bemis Ent. by (signature) Rosa Dodson

INSTRUCTIONS: Use typewriter or ball point pen, PLEASE PRESS FIRMLY and PRINT clearly. Please fill in blanks, underline or circle the correct answers. Send top three copies to Kansas Department of Health and Environment, Division of Environment, Environmental Geology Section, Topeka, KS 66620. Send one to WATER WELL OWNER and retain one for your records.

OFFICE USE ONLY
T
28 R
16
EW
SEC. 1
W/2 1/4 W/2 1/4 NE 1/4