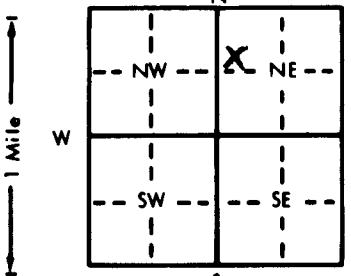


1 LOCATION OF WATER WELL: Fraction Section Number Township Number Range Number  
 County: Kiowa SW 1/4 NW 1/4 NE 1/4 9 T 28 S R 16 W EW

Distance and direction from nearest town or city street address of well if located within city?  
2E .82N 2410'W of Haviland, Kansas

2 WATER WELL OWNER: Aldebaran Drilling Co.  
 RR#, St. Address, Box #: Box 18611 Board of Agriculture, Division of Water Resources  
 City, State, ZIP Code: Wichita, Kansas 67207 Davis-Day #2 Application Number: T86-134

3 LOCATE WELL'S LOCATION WITH AN "X" IN SECTION BOX:  

 4 DEPTH OF COMPLETED WELL: 160 ft. ELEVATION: .....ft.  
 Depth(s) Groundwater Encountered 1. 96 ft. 2. ....ft. 3. ....ft.  
 WELL'S STATIC WATER LEVEL: 88 ft. below land surface measured on mo/day/yr 5 Mar 86  
 Pump test data: Well water was .....ft. after ..... hours pumping ..... gpm  
 Est. Yield 80 gpm: Well water was .....ft. after ..... hours pumping ..... gpm  
 Bore Hole Diameter: 10 in. to 160 ft., and ..... in. to ..... ft.  
 WELL WATER TO BE USED AS:  
 5 Public water supply 8 Air conditioning 11 Injection well  
 1 Domestic 3 Feedlot  Oil field water supply 9 Dewatering 12 Other (Specify below)  
 2 Irrigation 4 Industrial 7 Lawn and garden only 10 Observation well  
 Was a chemical/bacteriological sample submitted to Department? Yes.....No  .....; If yes, mo/day/yr sample was submitted  
 Water Well Disinfected? Yes  No

5 TYPE OF BLANK CASING USED:  
 1 Steel 3 RMP (SR) 5 Wrought iron 8 Concrete tile CASING JOINTS: Glued  Clamped .....  
 2 PVC 4 ABS 6 Asbestos-Cement 9 Other (specify below) Welded .....  
 7 Fiberglass Threaded.....  
 Blank casing diameter: 5 in. to 140 ft., Dia. ....in. to .....ft., Dia. ....in. to .....ft.  
 Casing height above land surface: 12 in., weight 2.34 lbs./ft. Wall thickness or gauge No. 214  
 TYPE OF SCREEN OR PERFORATION MATERIAL:  
 7 PVC 10 Asbestos-cement  
 1 Steel 3 Stainless steel 5 Fiberglass 8 RMP (SR) 11 Other (specify) .....  
 2 Brass 4 Galvanized steel 6 Concrete tile 9 ABS 12 None used (open hole)  
 SCREEN OR PERFORATION OPENINGS ARE:  
 5 Gauzed wrapped  8 Saw cut 11 None (open hole)  
 1 Continuous slot 3 Mill slot 6 Wire wrapped 9 Drilled holes  
 2 Louvered shutter 4 Key punched 7 Torch cut 10 Other (specify) .....  
 SCREEN-PERFORATED INTERVALS: From 140 ft. to 160 ft., From .....ft. to .....ft.  
 From .....ft. to .....ft., From .....ft. to .....ft.  
 GRAVEL PACK INTERVALS: From 10 ft. to 160 ft., From .....ft. to .....ft.  
 From .....ft. to .....ft., From .....ft. to .....ft.

6 GROUT MATERIAL: 1 Neat cement  2 Cement grout 3 Bentonite 4 Other .....  
 Grout intervals: From 0 ft. to 10 ft., From .....ft. to .....ft., From .....ft. to .....ft.  
 What is the nearest source of possible contamination:  
 1 Septic tank 4 Lateral lines 7 Pit privy 10 Livestock pens 14 Abandoned water well  
 2 Sewer lines 5 Cess pool 8 Sewage lagoon 11 Fuel storage 15 Oil well/Gas well  
 3 Watertight sewer lines 6 Seepage pit 9 Feedyard 12 Fertilizer storage 16 Other (specify below)  
 13 Insecticide storage ..... none.....  
 Direction from well? How many feet?

FROM	TO	LITHOLOGIC LOG	FROM	TO	LITHOLOGIC LOG
0	2	Soil			
2	45	Clay, tan			
45	70	Sand, fine to coarse and fine gravel			
70	96	Clay, tan			
96	116	Sand, fine to coarse and fine gravel			
116	136	Clay, tan and white			
136	160	Sand, fine to coarse and fine to med gravel			

7 CONTRACTOR'S OR LANDOWNER'S CERTIFICATION: This water well was (3) constructed, (2) reconstructed, or (3) plugged under my jurisdiction and was completed on (mo/day/year) 5 Mar 86 and this record is true to the best of my knowledge and belief. Kansas Water Well Contractor's License No. 325 This Water Well Record was completed on (mo/day/yr) 13 Mar 86 under the business name of Central Well and Pump by (signature) [Signature]

INSTRUCTIONS: Use typewriter or ball point pen. PLEASE PRESS FIRMLY and PRINT clearly. Please fill in blanks, underline or circle the correct answers. Send top three copies to Kansas Department of Health and Environment, Office of Oil Field and Environmental Geology, Regulation and Permitting Section, Topeka, Kansas 66620-7500, Telephone: 913-862-9360. Send one to WATER WELL OWNER and retain one for your records.

OFFICE USE ONLY  
T  
R  
EW  
SEC.  
1/4  
1/4  
1/4