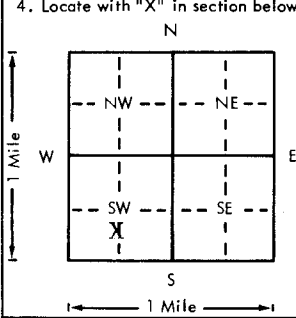


USE TYPEWRITER OR BALL POINT PEN-PRESS FIRMLY, PRINT CLEARLY.

WATER WELL RECORD
KSA 82a-1201-1215

Kansas Department of Health and Environment
Division of Environment
(Water well Contractors)
Topeka, Kansas 66620

1. Location of well:		County Kiowa	Fraction center of $S\frac{1}{2}$ 1/4 1/4 SW 1/4	Section number 12	Township number T 28	Range number S R 16 E W
2. Distance and direction from nearest town or city: Street address of well location if in city: In Wellsford Kansas				3. Owner of well: Keith Brown R.R. or street: 408 East 5th City, state, zip code: Ellinwood, KS 67526		
4. Locate with "X" in section below: Sketch map: 				6. Bore hole dia. 9 in. Completion date 5-16-79 Well depth 122 1/2 ft. 142 1/2 ft.		
5. Type and color of material				From	To	7. <input type="checkbox"/> Cable tool <input checked="" type="checkbox"/> Rotary <input type="checkbox"/> Driven <input type="checkbox"/> Dug <input type="checkbox"/> Hollow rod <input type="checkbox"/> Jetted <input type="checkbox"/> Bored <input type="checkbox"/> Reverse rotary
Sandy top soil				0	2	8. Use: <input checked="" type="checkbox"/> Domestic <input type="checkbox"/> Public supply <input type="checkbox"/> Industry <input type="checkbox"/> Irrigation <input type="checkbox"/> Air conditioning <input type="checkbox"/> Stock <input type="checkbox"/> Lawn <input type="checkbox"/> Oil field water <input type="checkbox"/> Other
Brown & gray sandy clay - Very hard				2	7	9. Casing: Material Styrene Height: <input checked="" type="checkbox"/> Above <input type="checkbox"/> Below Threaded <input type="checkbox"/> Welded <input checked="" type="checkbox"/> Surface 12 in. RMP <input type="checkbox"/> PVC <input checked="" type="checkbox"/> Weight 1.5 1.5 lbs./ft. Dia. 5 in. to 122 ft. depth Wall Thickness: inches or Dia. <input type="checkbox"/> in. to <input type="checkbox"/> ft. depth gage No. .200
Brown sandy clay - Very Hard				7	13	10. Screen: Manufacturer's name Jess & Lowell Type Styrene 200 Dia. 5" <input checked="" type="checkbox"/> Slot gauge 1/8" Length 20' Set between 122 1/2 ft. and 142 1/2 ft. <input type="checkbox"/> ft. and <input type="checkbox"/> ft. Gravel pack? <input checked="" type="checkbox"/> Yes Size range of material 3/8-200
Gray sandy clay				13	15	11. Static water level: <input type="checkbox"/> mo./day/yr. 83' 4" ft. below land surface Date 5-16-79
Gray & brown sandy clay				15	38	12. Pumping level below land surfaces: N/C <input type="checkbox"/> ft. after <input type="checkbox"/> hrs. pumping <input type="checkbox"/> g.p.m. <input type="checkbox"/> ft. after <input type="checkbox"/> hrs. pumping <input type="checkbox"/> g.p.m. Estimated maximum yield <input type="checkbox"/> g.p.m.
Brown clay, very sandy, 75-soft, 78-Hard				38	90	13. Water sample submitted: <input type="checkbox"/> mo./day/yr. <input type="checkbox"/> Yes <input checked="" type="checkbox"/> No Date <input type="checkbox"/>
Fine sand & gravel with clay streaks				90	96	14. Well head completion: <input type="checkbox"/> Pitless adapter <input checked="" type="checkbox"/> 12 Inches above grade
Sand & gravel				96	112	15. Well grouted? <input checked="" type="checkbox"/> Yes With: <input checked="" type="checkbox"/> Neat cement <input type="checkbox"/> Bentonite <input type="checkbox"/> Concrete Depth: From <input type="checkbox"/> ft. to <input type="checkbox"/> ft.
White sandy clay				112	123	16. Nearest source of possible contamination: FIELD ft. <input type="checkbox"/> Direction <input type="checkbox"/> Type <input type="checkbox"/> Well disinfected upon completion? <input checked="" type="checkbox"/> Yes <input type="checkbox"/> No
Sand & gravel & Caliche streaks				123	136	17. Pump: <input type="checkbox"/> Not installed Manufacturer's name Berkeley Pump Co. Model number 4AM-11 HP 1/2 Volts 230 Length of drop pipe 122' ft. capacity 10 g.p.m. Type: <input checked="" type="checkbox"/> Submersible <input type="checkbox"/> Turbine <input type="checkbox"/> Jet <input type="checkbox"/> Reciprocating <input type="checkbox"/> Centrifugal <input type="checkbox"/> Other
Sand & gravel				150	153	20. Water well contractor's certification: This well was drilled under my jurisdiction and this report is true to the best of my knowledge and belief. Clarke Well & Eq., Inc. 185 Business name Great Bend, KS 67530 License No. <input type="checkbox"/> Address <input type="checkbox"/> Signed D.W. Clarke Date 5-30-79 Authorized representative
Tan clay				153	154	
Sand & gravel				154	158	18. Elevation: Topography: <input type="checkbox"/> Hill <input type="checkbox"/> Slope <input type="checkbox"/> Upland <input type="checkbox"/> Valley
Dakota clay (Use a second sheet if needed)				158	160	
19. Remarks:						

T 28
 R 16
 S 12
 E W
 1/4 1/4 1/4

Forward the white, blue and pink copies to the Department of Health and Environment

Form WWC-5