USE TYPEWRITER OR BALL POINT PEN-PRESS FIRMLY, PRINT CLEARLY.

WATER WELL RECORD
KSA 82a-1201-1215

Kansas Department of Health and Environment-Division of Environment
(Water well Contractors)
Topeka, Kansas 66620

1. Location of well:	County: Kiowa	Fraction: NW 1/4 NW 1/4 NE 1/4	Section number: 16	Township number: T 28 - [redacted] S	Range number: R 16 (E) (W)

2. Distance and direction from nearest town or city: 2 E. Haviland
Street address of well location if in city: Kansas

3. Owner of well: Phil Baker
R.R. or street:
City, state, zip code: Haviland Kansas

4. Locate with "X" in section below:

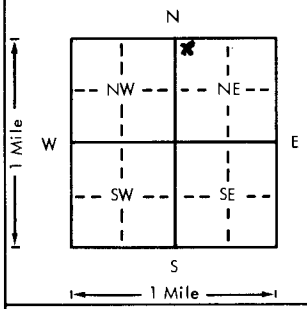

Sketch map:

6. Bore hole dia. 8 3/4 in. Completion date 6-18-77
Well depth 160 ft.

7. __ Cable tool X Rotary __ Driven __ Dug
__ Hollow rod __ Jetted __ Bored __ Reverse rotary

8. Use: X Domestic __ Public supply __ Industry
__ Irrigation __ Air conditioning __ Stock
__ Lawn __ Oil field water __ Other

9. Casing: Material Pl Glas Height: Above or below Surface 12 in.
Threaded ___ Welded ___
RMP X PVC ___ Weight — lbs./ft.
Dia. 5 in. to 140 ft. depth Wall Thickness: inches or gage No. 200
Dia. ___ in. to ___ ft. depth

10. Screen: Manufacturer's name Sun Flower Plastics
Type RMP Dia. 5
Slot/gauze 18 Length 20
Set between 140 ft. and 160 ft.
___ ft. and ___ ft.
Gravel pack? Yes Size range of material 1/8 to 5

11. Static water level: mo./day/yr.
110 ft. below land surface Date ___

12. Pumping level below land surfaces:
110 ft. after 1 hrs. pumping 5 g.p.m.
___ ft. after ___ hrs. pumping ___ g.p.m.
Estimated maximum yield ___ g.p.m.

13. Water sample submitted: mo./day/yr.
___ Yes X No Date ___

14. Well head completion:
X Pitless adapter 12 Inches above grade

15. Well grouted? Yes
With: X Neat cement ___ Bentonite ___ Concrete
Depth: From 3 ft. to 14 ft.

16. Nearest source of possible contamination:
ft. 60 Direction E. Type Barn
Well disinfected upon completion? X Yes ___ No

17. Pump: Not installed
Manufacturer's name Flint & Walling
Model number 7BH 12 HP 3/4 Volts 220
Length of drop pipe 126 ft. capacity 10 g.p.m.
Type:
X Submersible ___ Turbine
___ Jet ___ Reciprocating
___ Centrifugal ___ Other

5. Type and color of material	From	To
Top Soil	0	3
Lt. Br. Clay	3	56
Sandy Clay	56	61
Lt. Br. Clay	61	87
Gravel	87	118
Clay (Tuff)	118	124
Gravel	124	160

(Use a second sheet if needed)

18. Elevation:

Topography:
___ Hill
___ Slope
X Upland
___ Valley

19. Remarks:

20. Water well contractor's certification:
This well was drilled under my jurisdiction and this report is true to the best of my knowledge and belief.
Carl Hayes Water Well 224
Business name License No.
Address Greensburg Kansas
Signed Carl Hayes Date 6-18-77
Authorized representative

28 T 16 R (E) (W) 16 Sec ___ 1/4 ___ 1/4 ___ 1/4 ___ 1/4

Forward the white, blue and pink copies to the Department of Health and Environment

Form WWC-5

MI-1023