


1 LOCATION OF WATER WELL: County: Kiowa	Fraction: C 1/4 SE 1/4 NW 1/4	Section Number: 16	Township Number: T 28 S	Range Number: R 16 E/W
---	--------------------------------------	---------------------------	--------------------------------	-------------------------------

Distance and direction from nearest town or city street address of well if located within city?
2 3/4 west 1/4 south of Wellsford

2 WATER WELL OWNER: D, Chenoweth	Slawson Drilling	Board of Agriculture, Division of Water Resources
RR#, St. Address, Box #: Haviland, Ks.	Box 1409	Application Number: T84-288
City, State, ZIP Code: Great Bend, Ks, 67530		

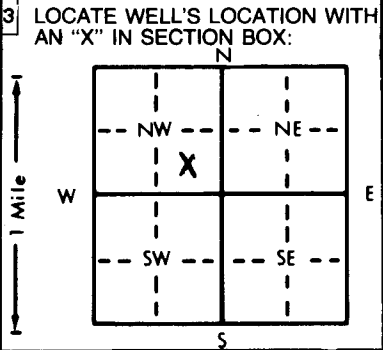

4 DEPTH OF COMPLETED WELL: 220 ft. ELEVATION:	Depth(s) Groundwater Encountered: 1. 71 ft. 2. ft. 3. ft.
WELL'S STATIC WATER LEVEL: 120 ft. below land surface measured on mo/day/yr 5-26-84	
Pump test data: Well water was ft. after hours pumping gpm	
Est. Yield: NA gpm: Well water was ft. after hours pumping gpm	
Bore Hole Diameter: 10 in. to 220 ft., and in. to ft.	
WELL WATER TO BE USED AS:	
5 Public water supply	8 Air conditioning
1 Domestic	3 Feedlot
2 Irrigation	4 Industrial
6 <u>Oil field water supply</u>	9 Dewatering
7 Lawn and garden only	10 Observation well
11 Injection well	12 Other (Specify below)
Was a chemical/bacteriological sample submitted to Department? Yes.....No. X; If yes, mo/day/yr sample was submitted	
Water Well Disinfected? Yes HTH No	

5 TYPE OF BLANK CASING USED:	5 Wrought iron	8 Concrete tile
1 Steel	3 RMP (SR)	6 Asbestos-Cement
<u>2 PVC</u>	4 ABS	7 Fiberglass
Blank casing diameter: 5 in. to 200 ft., Dia. in. to ft., Dia. in. to ft.	CASING JOINTS: Glued X Clamped	
Casing height above land surface: 18 in., weight lbs./ft. Wall thickness or gauge No. 258	Welded	
TYPE OF SCREEN OR PERFORATION MATERIAL:		
1 Steel	3 Stainless steel	5 Fiberglass
2 Brass	4 Galvanized steel	6 Concrete tile
SCREEN OR PERFORATION OPENINGS ARE:		
1 Continuous slot	3 Mill slot	5 Gauzed wrapped
2 Louvered shutter	4 Key punched	6 Wire wrapped
SCREEN-PERFORATED INTERVALS: From 200 ft. to 220 ft., From ft. to ft.		
GRAVEL PACK INTERVALS: From 10 ft. to 220 ft., From ft. to ft.		
TYPE OF SCREEN OR PERFORATION MATERIAL: 7 PVC 10 Asbestos-cement		
SCREEN OR PERFORATION OPENINGS ARE: 8 Saw cut 11 None (open hole)		

6 GROUT MATERIAL: 1 Neat cement	2 Cement grout	3 <u>Bentonite</u>
Grout Intervals: From 0 ft. to 10 ft., From ft. to ft., From ft. to ft.		
What is the nearest source of possible contamination:		
1 Septic tank	4 Lateral lines	7 Pit privy
2 Sewer lines	5 Cess pool	8 Sewage lagoon
3 Watertight sewer lines	6 Seepage pit	9 Feedyard
		10 Livestock pens
		11 Fuel storage
		12 Fertilizer storage
		13 Insecticide storage
		14 Abandoned water well
		<u>15 Oil well/Gas well</u>
		16 Other (specify below)
Direction from well? west		How many feet? 80

FROM	TO	LITHOLOGIC LOG	FROM	TO	LITHOLOGIC LOG
0	2	Top soil			
2	18	Clay			
18	24	Sand			
24	48	Clay			
48	71	Clay and sand			
71	90	Sand & gravel & clay layers			
90	220	Sand and gravel			
220		Sandy clay			

7 CONTRACTOR'S OR LANDOWNER'S CERTIFICATION: This water well was (1) <u>constructed</u> , (2) reconstructed, or (3) plugged under my jurisdiction and was completed on (mo/day/year) 5-26-84 and this record is true to the best of my knowledge and belief. Kansas Water Well Contractor's License No. 134 This Water Well Record was completed on (mo/day/yr) 6-18-84 under the business name of Rosencrantz-Bemis Ent. by signature Lora Dodson

INSTRUCTIONS: Use typewriter or ball point pen, **PLEASE PRESS FIRMLY** and **PRINT** clearly. Please fill in blanks, underline or circle the correct answers. Send top three copies to Kansas Department of Health and Environment, Division of Environment, Environmental Geology Section, Topeka, KS 66620. Send one to WATER WELL OWNER and retain one for your records.

OFFICE USE ONLY T R E/W SEC. 1/4 1/4 1/4