


1 LOCATION OF WATER WELL: Fraction SW 1/4 SE 1/4 SW 1/4 Section Number 34 Township Number T 28 S Range Number R 16 E/W  
 County: KIOWA

Distance and direction from nearest town or city street address of well if located within city?  
1/4 5 2 1/2 E. Haviland Kansas

2 WATER WELL OWNER: Jack Kuhn  
 RR#, St. Address, Box #: 501 S. PINE City, State, ZIP Code: Pratt Kans.  
 Board of Agriculture, Division of Water Resources Application Number:

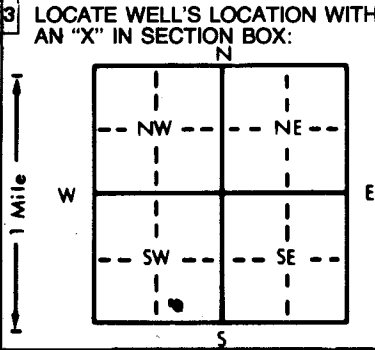

4 DEPTH OF COMPLETED WELL: 83 ft. ELEVATION:  
 Depth(s) Groundwater Encountered 1. 52 ft. 2. ft. 3. ft.  
 WELL'S STATIC WATER LEVEL: 32 ft. below land surface measured on mo/day/yr 11-18-81  
 Pump test data: Well water was 32 ft. after 1 hours pumping 3 gpm  
 Est. Yield 25 gpm. Well water was ft. after hours pumping gpm  
 Bore Hole Diameter: 8 3/4 in. to 8 3/8 ft. and in. to ft.  
 WELL WATER TO BE USED AS:  
 5 Public water supply 8 Air conditioning 11 Injection well  
 1 Domestic 3 Feedlot 6 Oil field water supply 9 Dewatering 12 Other (Specify below)  
 2 Irrigation 4 Industrial 7 Lawn and garden only 10 Observation well PASTURE  
 Was a chemical/bacteriological sample submitted to Department? Yes No X; If yes, mo/day/yr sample was submitted  
 Water Well Disinfected? Yes X No

5 TYPE OF BLANK CASING USED:  
 1 Steel 2 PVC 3 RMP (SR) 4 ABS  
 5 Wrought iron 6 Asbestos-Cement 7 Fiberglass 8 Concrete tile 9 Other (specify below)  
 CASING JOINTS: Glued X Clamped Welded Threaded  
 Blank casing diameter 5 in. to 6.3 ft., Dia. in. to ft., Dia. in. to ft.  
 Casing height above land surface 12 in., weight 1.75 lbs./ft. Wall thickness or gauge No. SDR-26

TYPE OF SCREEN OR PERFORATION MATERIAL:  
 1 Steel 2 Brass 3 Stainless steel 4 Galvanized steel 5 Fiberglass 6 Concrete tile 7 PVC 8 RMP (SR) 9 ABS 10 Asbestos-cement 11 Other (specify) 12 None used (open hole)

SCREEN OR PERFORATION OPENINGS ARE:  
 1 Continuous slot 2 Louvered shutter 3 Mill slot 4 Key punched 5 Gauzed wrapped 6 Wire wrapped 7 Torch cut 8 Saw cut 9 Drilled holes 11 None (open hole)

SCREEN-PERFORATED INTERVALS:  
 From 6.3 ft. to 8.3 ft. From ft. to ft. From ft. to ft.  
 GRAVEL PACK INTERVALS:  
 From 4.9 ft. to 8.3 ft. From ft. to ft. From ft. to ft.

6 GROUT MATERIAL: 1 Neat cement 2 Cement grout 3 Bentonite 4 Other  
 Grout intervals: From 0 ft. to 1.0 ft., From ft. to ft., From ft. to ft.

What is the nearest source of possible contamination:  
 1 Septic tank 2 Sewer lines 3 Watertight sewer lines 4 Lateral lines 5 Cess pool 6 Seepage pit 7 Pit privy 8 Sewage lagoon 9 Feedyard 10 Livestock pens 11 Fuel storage 12 Fertilizer storage 13 Insecticide storage 14 Abandoned water well 15 Oil well/Gas well 16 Other (specify below)  
PASSING CATTLE  
 Direction from well? ← How many feet?

FROM	TO	LITHOLOGIC LOG	FROM	TO	LITHOLOGIC LOG
0	2	Top Soil			
2	23	Sand			
23	27	Clay			
27	83	Gravel			

7 CONTRACTOR'S OR LANDOWNER'S CERTIFICATION: This water well was (1) constructed, (2) reconstructed, or (3) plugged under my jurisdiction and was completed on (mo/day/year) 11-18-81 and this record is true to the best of my knowledge and belief. Kansas Water Well Contractor's License No. 224 This Water Well Record was completed on (mo/day/yr) 11-19-81 under the business name of Carl Hays Water Well Service by (signature) Carl Hays  
 INSTRUCTIONS: Use typewriter or ball point pen, PLEASE PRESS FIRMLY and PRINT clearly. Please fill in blanks, underline or circle the correct answers. Send top three copies to Kansas Department of Health and Environment, Division of Environment, Environmental Geology Section, Topeka, KS 66620. Send one to WATER WELL OWNER and retain one for your records.

OFFICE USE ONLY T 28 R 16 E/W SEC. 34 SW 1/4 SE 1/4 SW 1/4