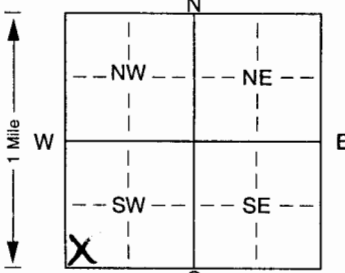


1 LOCATION OF WATER WELL: Fraction SW 1/4 SW 1/4 SW 1/4 Section Number 35 Township Number T 28 S Range Number R 16 E (W)  
 County: Kiowa  
 Distance and direction from nearest town or city street address of well if located within city? From US 54 & SW 150th Ave. E. of Wellstead, KS go S. on SW 150th Ave. 4.5 mls to SW 60th St. go W. on SW 60th 2 mls. on NE corner of intersection  
 2 WATER WELL OWNER: Magellan Midstream Partners, LP 3 Wells  
 RR#, St. Address, Box #: One Williams Center / MD 27-4 Board of Agriculture, Division of Water Resources  
 City, State, ZIP Code: Tulsa, OK 74172 Application Number:

3 LOCATE WELL'S LOCATION WITH AN "X" IN SECTION BOX:  
  
 4 DEPTH OF COMPLETED WELL: 70 ft. ELEVATION:  
 Depth(s) Groundwater Encountered 1. 65 ft. 2. . . . . ft. 3. . . . . ft.  
 WELL'S STATIC WATER LEVEL: N/A ft. below land surface measured on mo/day/yr . . . . .  
 Pump test data: Well water was N/A ft. after . . . . . hours pumping . . . . . gpm  
 Est. Yield . . . . . gpm; Well water was N/A ft. after . . . . . hours pumping . . . . . gpm  
 Bore Hole Diameter: 7.5 in. to 70 ft., and . . . . . in. to . . . . . ft.  
 WELL WATER TO BE USED AS:  
 5 Public water supply 8 Air conditioning 11 Injection well  
 1 Domestic 3 Feedlot 6 Oil field water supply 9 Dewatering 12 Other (Specify below)  
 2 Irrigation 4 Industrial 7 Domestic (lawn & garden) 10 Monitoring well  
 Was a chemical/bacteriological sample submitted to Department? Yes. . . . . No . . . . . ; If yes, mo/day/yr sample was submitted  
 Water Well Disinfected? Yes No

5 TYPE OF BLANK CASING USED:  
 1 Steel 3 RMP (SR) 5 Wrought iron 8 Concrete tile CASING JOINTS: Glued. . . . . Clamped. . . . .  
 2 PVC 4 ABS 6 Asbestos-Cement 9 Other (specify below) Welded . . . . .  
 7 Fiberglass Threaded Threaded  
 Blank casing diameter: 2 in. to 60 ft., Dia. . . . . in. to . . . . . ft., Dia. . . . . in. to . . . . . ft.  
 Casing height above land surface: 0-4 @ 30 in., weight .72 lbs./ft. Wall thickness or gauge No. 5ch 40  
 TYPE OF SCREEN OR PERFORATION MATERIAL:  
 1 Steel 3 Stainless steel 5 Fiberglass 7 PVC 10 Asbestos-cement  
 2 Brass 4 Galvanized steel 6 Concrete tile 8 RMP (SR) 11 Other (specify) . . . . .  
 9 ABS 12 None used (open hole)  
 SCREEN OR PERFORATION OPENINGS ARE:  
 1 Continuous slot 3 Mill slot 5 Gauzed wrapped 8 Saw cut 11 None (open hole)  
 2 Louvered shutter 4 Key punched 6 Wire wrapped 9 Drilled holes  
 7 Torch cut 10 Other (specify) . . . . . ft.  
 SCREEN-PERFORATED INTERVALS: From 60 ft. to 70 ft., From . . . . . ft. to . . . . . ft.  
 From . . . . . ft. to . . . . . ft., From . . . . . ft. to . . . . . ft.  
 GRAVEL PACK INTERVALS: From 58 ft. to 70 ft., From . . . . . ft. to . . . . . ft.  
 From . . . . . ft. to . . . . . ft., From . . . . . ft. to . . . . . ft.

6 GROUT MATERIAL: 1 Neat cement 2 Cement grout 3 Bentonite 4 Other Concrete  
 Grout Intervals: From 0 ft. to 3 ft., From 3 ft. to 58 ft., From . . . . . ft. to . . . . . ft.  
 What is the nearest source of possible contamination:  
 1 Septic tank 4 Lateral lines 7 Pit privy 10 Livestock pens 14 Abandoned water well  
 2 Sewer lines 5 Cess pool 8 Sewage lagoon 11 Fuel storage 15 Oil well/Gas well  
 3 Watertight sewer lines 6 Seepage pit 9 Feedyard 12 Fertilizer storage 16 Other (specify below) Amoria Lines  
 13 Insecticide storage  
 Direction from well? N 4 S How many feet? 15'

FROM	TO	LITHOLOGIC LOG	FROM	TO	PLUGGING INTERVALS
0	2	Dk. Brown - Silt			
2	5	Lt. Brown - Silty Loam			
5	10	Lt. Brown - Sandy Loam			
10	35	Lt. Brown - Sand			
35	56	Lt. Brown - Clayey Sand			
56	60	Gray - Clay			
60	70	Gray - Clayey Sand			

7 CONTRACTOR'S OR LANDOWNER'S CERTIFICATION: This water well was (1) constructed, (2) reconstructed, or (3) plugged under my jurisdiction and was completed on (mo/day/year) 3/1/06 and this record is true to the best of my knowledge and belief. Kansas Water Well Contractor's Licence No. 676 This Water Well Record was completed on (mo/day/yr) 3/13/06 under the business name of Whitetail Drilling, LLC by (signature) Andy Bantz