


WATER WELL RECORD Form WWC-5 KSA 82a-1212

1 LOCATION OF WATER WELL: Fraction Section Number Township Number Range Number
 COUNTY: 049 KIOWA SE 1/4 SE 1/4 NW 1/4 6 T 28 S R 17 W

Distance and direction from nearest town or city street address of well if located within city?
 3 E. 2 N. OF GREENSBURG, KS

2 WATER WELL OWNER: PICKRELL DRILLING 334 Board of Agriculture, Division of Water Resources
 RR#, St. Address, Box #: 110 N. MARKET SUITE 205
 City, State, ZIP code : WICHITA, KS 67202-1996 Application Number:

3 LOCATE WELL'S LOCATION WITH AN "X" IN SECTION BOX:

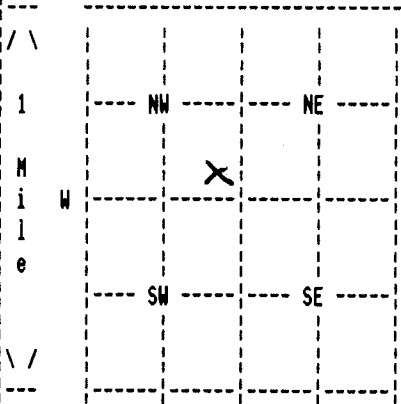

4 DEPTH OF COMPLETED WELL 112 ELEVATION: 0
 Depth(s) Groundwater Encountered 1. 70 ft. 2. 0 ft. 3. 0 ft.
 WELL'S STATIC WATER LEVEL 70 ft. below land surface measured on mo/day/yr
 Pump testdata: Well water was 0 ft. after 0 hours pumping 0 gpm
 Estimated Yield 0 gpm: Well water was 0 ft. after 0 hours pumping 0 gpm
 Bore Hole Diameter 8.75 in. to 112 ft., and in. to 0 ft.
 WELL WATER TO BE USED AS: 06 OIL FIELD
 Was a chemical/bacteriological sample submitted to department? No ;
 If yes, mo/day/yr sample was submitted Water well disinfected? Yes

5 TYPE OF BLANK CASING USED: 02 PVC CASING JOINTS: GLUED
 Blank casing diameter 5 in. to 92 ft., Dia in. to 0 ft., Dia in. to 0 ft.
 Casing height above land surface 12 in., weight 0 lbs/ft. Wall thickness or gauge No. 26
 TYPE OF SCREEN OR PERFORATION MATERIAL: 07 PVC
 SCREEN OR PERFORATION OPENINGS ARE: 08 SAW CUT

SCREEN PERFORATED INTERVALS: From 92 ft. to 112 ft., From 0 ft. to 0 ft.
 From 0 ft. to 0 ft., From 0 ft. to 0 ft.
 GRAVEL PACK INTERVALS: From 25 ft. to 112 ft., From 0 ft. to 0 ft.
 From 0 ft. to 0 ft., From 0 ft. to 0 ft.

6 GROUT MATERIAL 03 BENTONITE
 Grout Intervals: From 1 ft. to 25 ft., From 0 ft. to 0 ft., From 0 ft. to 0 ft.
 What is the nearest source of possible contamination: 15 OIL/GAS WELL
 Direction from well? NE How many feet? 60

FROM	TO	LITHOLOGIC LOG	FROM	TO	PLUGGING INTERVALS
0	14	SILT & SAND			
14	21	TAN CLAY			
21	27	05 SAND AND 17 GRAVEL			
27	41	TAN CLAY			
41	79	05 SAND AND 17 GRAVEL			
79	112	05 SAND AND CLAY			
112	0	TAN CLAY			

7 CONTRACTOR'S OR LANDOWNER'S CERTIFICATION: This water well was constructed under my jurisdiction and was completed on (mo/day/year) 8-5-95 and this record is true to the best of my knowledge and belief. Kansas Water Well Contractor's License No. 224 This Water Well Record was completed on (mo/day/yr) 09/16/95 under the business name of CARL HAYSE WATER WELL SVC by (signature) Carl Hayse