


| | | | | | |
|---|-------------------------|-----------------------------|----------------|-----------------|--------------|
| 1 | LOCATION OF WATER WELL: | Fraction | Section Number | Township Number | Range Number |
| | County: KIOWA | SW 1/4 SW 1/4 SE 1/4 | 21 | 28 S | 17 W |

Distance and direction from nearest town or city street address of well if located within city? **North into 728 West**
4 MILES WEST OF HAMILAND, KS. 2 miles south of Hwy 54 Then 1/4 mile west

2 WATER WELL OWNER: **Royce FRAZIER**
 RR #, St. Address, Box #: **RT 2**
 City, State, ZIP Code : **HAMILAND, KS 67059**
 Board of Agriculture, Division of Water Resources
 Application Number: _____

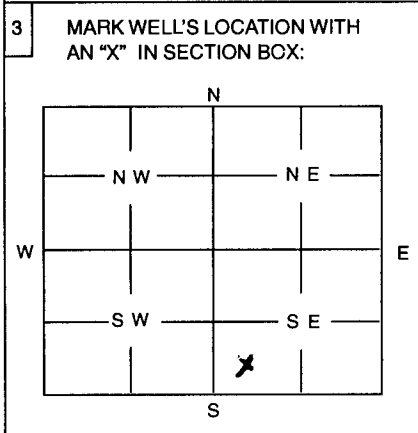

4 DEPTH OF WELL **97** ft
 WELL'S STATIC WATER LEVEL **999** ft. **NO WATER DRY WELL**
 WELL WAS USED AS:
 1 Domestic 5 Public Water Supply 9 Dewatering
 2 Irrigation 6 Oil Field Water Supply 10 Monitoring Well
 3 Feedlot 7 Domestic (Lawn & Garden) 11 Injection Well
 4 Industrial 8 Air Conditioning 12 Other

Was a chemical / bacteriological sample submitted to Department? Yes No
 If yes, mo/day/yr sample was submitted

Water Well Disinfected: Yes No

5 TYPE OF BLANK CASING USED:
 Steel 3 RMP (SR) 5 Wrought 7 Fiberglass 9 Other (Specify below)
 2 PVC 4 ABS 6 Asbestos-Cement 8 Concrete Tile

Blank casing diameter... **3** in. Was casing pulled? Yes No
 Casing height above or below land surface **0** in. If yes, how much

6 GROUT PLUG MATERIAL: 1 Neat cement 2 Cement grout 3 Bentonite 4 Other **SANTALIOD GRAVEL**
 Grout Plug Intervals: From **97** ft. to **6** ft., From **0** ft. to **3** ft., From **3** to **0** ft.

What is the nearest source of possible contamination:
 1 Septic tank 6 Seepage pit 11 Fuel storage 16 Other (specify below) **999**
 2 Sewer lines 7 Pit privy 12 Fertilizer storage
 3 Watertight sewer lines 8 Sewage lagoon 13 Insecticide storage
 4 Lateral lines 9 Feedyard 14 Abandoned water well
 5 Cess Pool 10 Livestock pens 15 Oil well/Gas well

Direction from well? **South EAST** How many feet? **300'**

| FROM | TO | PLUGGING MATERIALS |
|------------|-----------|-------------------------|
| 97' | 6' | SANTALIOD GRAVEL |
| 6' | 3' | Bentonite |
| 3' | 0" | NEAT CEMENT |
| | | |
| | | |
| | | |

7 CONTRACTOR'S OR LANDOWNER'S CERTIFICATION: This water well was plugged under my jurisdiction and was completed on (mo/day/year) **5-29-01** and this record is true to the best of my knowledge and belief. Kansas Water Well Contractor's License No. **665** This Water Well Record was completed on (mo/day/year) **5-29-01** under the business name of **PRATT WELL SERVICE ENVIRONMENTAL** by (signature) **[Signature]**

INSTRUCTIONS: Use typewriter or ball point pen. Please press firmly and print clearly. Please fill in blanks, underline or circle the correct answers. Send top three copies to Kansas Department of Health and Environment, Bureau of Water, Topeka, Kansas 66620-0001. Telephone: 785/296-3565. Send one to Water Well Owner and retain one for your records.