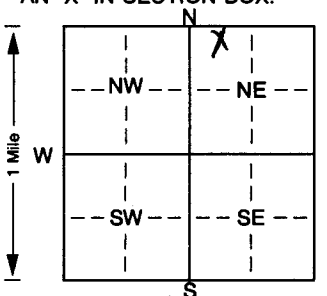


1 LOCATION OF WATER WELL: Fraction N 1/2 1/4 NW 1/4 NE 1/4 Section Number 7 Township Number T 28 S Range Number R 17 EW
 County: Kiowa
 Distance and direction from nearest town or city street address of well if located within city?
3 3/4 east, 3/4 north of Greensburg, Ks.

2 WATER WELL OWNER: Advantage Resources Inc,
 RR#, St. Address, Box # : 1775 Sherman St. - STE 1900 Board of Agriculture, Division of Water Resources
 City, State, ZIP Code : Denver, Co. 80203-4316 Application Number: 20010177

3 LOCATE WELL'S LOCATION WITH AN "X" IN SECTION BOX:  4 DEPTH OF COMPLETED WELL: 150 ft. ELEVATION: ft.
 Depth(s) Groundwater Encountered 1. ft. 2. ft. 3. ft.
 WELL'S STATIC WATER LEVEL 71 ft. below land surface measured on mo/day/yr 8-27-01
 Pump test data: Well water was ft. after hours pumping gpm
 Est. Yield NA gpm; Well water was ft. after hours pumping gpm
 Bore Hole Diameter 9 7/8 in. to 155 ft., and in. to ft.
 WELL WATER TO BE USED AS: 5 Public water supply 8 Air conditioning 11 Injection well
 1 Domestic 3 Feedlot 6 Oil field water supply 9 Dewatering 12 Other (Specify below)
 2 Irrigation 4 Industrial 7 Domestic (lawn & garden) 10 Monitoring well
 Was a chemical/bacteriological sample submitted to Department? Yes. No. X ; If yes, mo/day/yr sample was submitted
 Water Well Disinfected? Yes No X

5 TYPE OF BLANK CASING USED: 5 Wrought iron 8 Concrete tile CASING JOINTS: Glued. X Clamped.
 1 Steel 3 RMP (SR) 6 Asbestos-Cement 9 Other (specify below) Welded
2 PVC 4 ABS 7 Fiberglass Threaded.
 Blank casing diameter 5 in. to 128 ft. Dia in. to ft. Dia in. to ft.
 Casing height above land surface 24 in., weight SDR-26 lbs./ft. Wall thickness or gauge No.
 TYPE OF SCREEN OR PERFORATION MATERIAL: 7 PVC 10 Asbestos-cement
 1 Steel 3 Stainless steel 5 Fiberglass 8 RMP (SR) 11 Other (specify)
 2 Brass 4 Galvanized steel 6 Concrete tile 9 ABS 12 None used (open hole)
 SCREEN OR PERFORATION OPENINGS ARE: 5 Gauzed wrapped 8 Saw cut 11 None (open hole)
 1 Continuous slot 3 Mill slot 6 Wire wrapped 9 Drilled holes
 2 Louvered shutter 4 Key punched 7 Torch cut 10 Other (specify) ft.
 SCREEN-PERFORATED INTERVALS: From 128 ft. to 148 ft., From ft. to ft.
 From ft. to ft., From ft. to ft.
 GRAVEL PACK INTERVALS: From 155 ft. to 20 ft., From ft. to ft.
 From ft. to ft., From ft. to ft.

6 GROUT MATERIAL: 1 Neat cement 2 Cement grout 3 Bentonite 4 Other hole plug
 Grout Intervals: From 20 ft. to 0 ft., From ft. to ft., From ft. to ft.
 What is the nearest source of possible contamination:
 1 Septic tank 4 Lateral lines 7 Pit privy 10 Livestock pens 14 Abandoned water well
 2 Sewer lines 5 Cess pool 8 Sewage lagoon 11 Fuel storage 15 Oil well/Gas well
 3 Watertight sewer lines 6 Seepage pit 9 Feedyard 12 Fertilizer storage 16 Other (specify below)
 13 Insecticide storage none
 Direction from well? How many feet?

FROM	TO	LITHOLOGIC LOG	FROM	TO	PLUGGING INTERVALS
0	3	Sandy top soil			
3	6	Sandy brown clay			
6	22	Brown clay			
22	29	Clay & sand mixed			
29	36	Bkrown & gray clay			
36	49	Clay & gravel mixed			
49	66	Sand & gravel clean, small, tight, w/ clay streaks			
66	143	Sand & gravel clean, small, tight			
143	155	Sand & gravel clay mixed			

7 CONTRACTOR'S OR LANDOWNER'S CERTIFICATION: This water well was (1) constructed, (2) reconstructed, or (3) plugged under my jurisdiction and was completed on (mo/day/year) 8-27-01 and this record is true to the best of my knowledge and belief. Kansas Water Well Contractor's Licence No. 134 This Water Well Record was completed on (mo/day/yr) 8-28-01 under the business name of / Rosenkrantz-Bemis by (signature) Freddie Rodson