USE TYPEWRITER OR BALL POINT PEN-PRESS FIRMLY, PRINT CLEARLY.

WATER WELL RECORD
KSA 82a-1201-1215

Kansas Department of Health and Environment-Division of Environment
(Water well Contractors)
Topeka, Kansas 66620

1. Location of well:	County: Kiowa	Fraction: 1/4 1/4 NW 1/4 (C)	Section number: 5	Township number: T 28 S	Range number: R 17 W

2. Distance and direction from nearest town or city: 2N 6W
Street address of well location if in city: Haviland, KS

3. Owner of well: Ronald Taylor
R.R. or street:
City, state, zip code: Haviland, KS

4. Locate with "X" in section below:

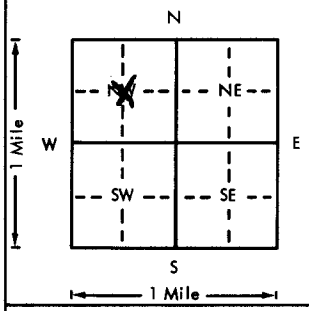

Sketch map:

6. Bore hole dia. 30 in. Completion date 2-16-77
Well depth 173 ft.

7. __ Cable tool __ Rotary __ Driven __ Dug
__ Hollow rod __ Jetted __ Bored X Reverse rotary

8. Use: __ Domestic __ Public supply __ Industry
X Irrigation __ Air conditioning __ Stock
__ Lawn __ Oil field water __ Other

9. Casing: Material Steel Height: (above) or below
Threaded ___ Welded X Surface 24 in.
RMP ___ PVC ___ Weight ___ lbs./ft.
Dia. 16 in. to 113 ft. depth Wall Thickness: inches or
Dia. ___ in. to ___ ft. depth gage No. 3/16"

5. Type and color of material	From	To
Sand	0	14
Clay	14	57
Sand-Gravel	57	125
Clay	125	130
Sand-Gravel	130	173

(Use a second sheet if needed)

10. Screen: Manufacturer's name Dorr
Type Steel Dia. 16"
Slot/gauze 118 Length 60'
Set between 113 ft. and 173 ft.
___ ft. and ___ ft.
Gravel pack? X Size range of material 1/8-3/4"

11. Static water level: mo./day/yr.
47 ft. below land surface Date 2-16-77

12. Pumping level below land surfaces:
65 ft. after 4 hrs. pumping 1000 g.p.m.
___ ft. after ___ hrs. pumping ___ g.p.m.
Estimated maximum yield 1500 g.p.m.

13. Water sample submitted: mo./day/yr.
__ Yes X No Date ___

14. Well head completion:
__ Pitless adapter 24 Inches above grade

15. Well grouted? ___
With: X Neat cement __ Bentonite __ Concrete
Depth: From 0 ft. to 10 ft.

16. Nearest source of possible contamination: None
ft. ___ Direction ___ Type ___
Well disinfected upon completion? ___ Yes X No

17. Pump: __ Not installed
Manufacturer's name Goulds
Model number 5125 HP 80 Volts ___
Length of drop pipe 140 ft. capacity 800 g.p.m.
Type:
__ Submersible X Turbine
__ Jet __ Reciprocating
__ Centrifugal __ Other

18. Elevation:

Topography:
__ Hill
__ Slope
X Upland
__ Valley

19. Remarks:

20. Water well contractor's certification:
This well was drilled under my jurisdiction and this report is true to the best of my knowledge and belief. 186
Kellys Water Well Ser
Business name License No.
Address R 2 Great Bend KS
Signed Kelly Price Date 4-20-77
Authorized representative

28 17 W 5 Sec
T R
NW 1/4 1/4 1/4

Forward the white, blue and pink copies to the Department of Health and Environment

Form WWC-5

M1-1023