

272

WATER WELL RECORD Form WWC-5 KSA 82a-1212


1 LOCATION OF WATER WELL: COUNTY: KIOWA Fraction SE 1/4 SW 1/4 NW 1/4 Section Number 7 Township Number T 28 S Range Number R 17 W

Distance and direction from nearest town or city street address of well if located within city? 3 MILES EAST, 1 MILE NORTH OF GREENSBURG

2 WATER WELL OWNER: ADVANTAGE RESOURCES RR#, St. Address, Box #: 1775 SHERMAN ST City, State, ZIP code: DENVER, CO 80203- Board of Agriculture, Division of Water Resources Application Number: 20060064

3 LOCATE WELL'S LOCATION WITH AN "X" IN SECTION BOX:

4 DEPTH OF COMPLETED WELL 127 ELEVATION: 0 Depth(s) Groundwater Encountered 1. 0 ft. 2. 0 ft. 3. 0 ft.

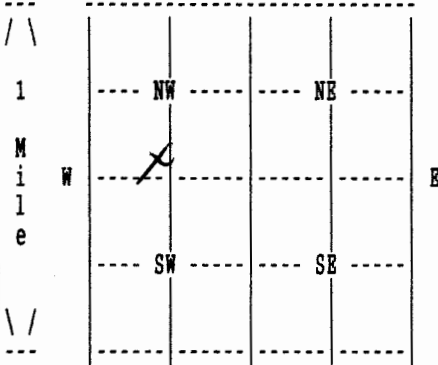

WELL'S STATIC WATER LEVEL 77 ft. below land surface measured on mo/day/yr 03/15/06 Pump test data: Well water was 0 ft. after 0 hours pumping 0 gpm Estimated Yield 0 gpm: Well water was 0 ft. after 0 hours pumping 0 gpm Bore Hole Diameter 8.75 in. to 127 ft., and in. to 0 ft. WELL WATER TO BE USED AS: OIL FIELD Was a chemical/bacteriological sample submitted to department? No; If yes, mo/day/yr sample was submitted Water well disinfected? Yes

5 TYPE OF BLANK CASING USED: PVC CASING JOINTS: GLUED Blank casing diameter 5 in. to 107 ft., Dia in. to 0 ft., Dia in. to 0 ft. Casing height above land surface 12 in., weight 0 lbs/ft. Wall thickness or gauge No. 26 TYPE OF SCREEN OR PERFORATION MATERIAL: PVC SCREEN OR PERFORATION OPENINGS ARE: SAW CUT

SCREEN PERFORATED INTERVALS: From 107 ft. to 127 ft., From 0 ft. to 0 ft. From 0 ft. to 0 ft., From 0 ft. to 0 ft. GRAVEL PACK INTERVALS: From 24 ft. to 127 ft., From 0 ft. to 0 ft. From 0 ft. to 0 ft., From 0 ft. to 0 ft.

6 GROUT MATERIAL BENTONITE Grout Intervals: From 0 ft. to 24 ft., From 0 ft. to 0 ft., From 0 ft. to 0 ft. What is the nearest source of possible contamination: SEPTIC TANK Direction from well? EAST How many feet? 2700

Table with columns: FROM, TO, LITHOLOGIC LOG, FROM, TO, PLUGGING INTERVALS. Rows show depth intervals (0-28, 28-45, 45-127) and lithology (SILT AND SAND, TAN CLAY, SAND AND GRAVEL).

7 CONTRACTOR'S OR LANDOWNER'S CERTIFICATION: This water well was Constructed under my jurisdiction and was completed on (mo/day/year) 03/15/06 and this record is true to the best of my knowledge and belief. Kansas Water Well Contractor's License No. 653 This Water Well Record was completed on (mo/day/yr) 03/17/06 under the business name of DAN HAYSE WATER WELL SERV by (signature) Dan Hayse