


WATER WELL RECORD Form WWC-5 KSA 82a-1212

1 LOCATION OF WATER WELL: Fraction Section Number Township Number Range Number  
 COUNTY: KIOWA NE 1/4 SW 1/4 NE 1/4 7 T 28 S R 17 W

Distance and direction from nearest town or city street address of well if located within city?  
 3 MILES EAST 1/2 NORTH OF GREENSBURG

2 WATER WELL OWNER: MCELWAIN, JAMIE Board of Agriculture, Division of Water Resources  
 RR#, St. Address, Box #: PO BOX Application Number:  
 City, State, ZIP code: HAVILAND, KS 67059-

3 LOCATE WELL'S LOCATION WITH AN "X" IN SECTION BOX:

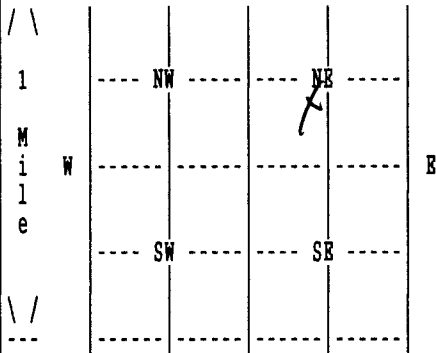

4 DEPTH OF COMPLETED WELL 140 ELEVATION: 0  
 Depth(s) Groundwater Encountered 1. 0 ft. 2. 0 ft. 3. 0 ft.

WELL'S STATIC WATER LEVEL 82 ft. below land surface measured on mo/day/yr 10/10/14  
 Pump test data: Well water was 0 ft. after 0 hours pumping 0 gpm

Estimated Yield 0 gpm: Well water was 0 ft. after 0 hours pumping 0 gpm

Bore Hole Diameter 8.75 in. to 140 ft., and in. to 0 ft.

WELL WATER TO BE USED AS: DOMESTIC

Was a chemical/bacteriological sample submitted to department? No ;  
 If yes, mo/day/yr sample was submitted Water well disinfected? Yes

5 TYPE OF BLANK CASING USED: PVC CASING JOINTS: GLUED  
 Blank casing diameter 5 in. to 120 ft., Dia in. to 0 ft., Dia in. to 0 ft.  
 Casing height above land surface 12 in., weight 0 lbs/ft. Wall thickness or gauge No. 26  
 TYPE OF SCREEN OR PERFORATION MATERIAL: PVC  
 SCREEN OR PERFORATION OPENINGS ARE: SAW CUT

SCREEN PERFORATED INTERVALS: From 120 ft. to 140 ft., From 0 ft. to 0 ft.  
 From 0 ft. to 0 ft., From 0 ft. to 0 ft.  
 GRAVEL PACK INTERVALS: From 35 ft. to 140 ft., From 0 ft. to 0 ft.  
 From 0 ft. to 0 ft., From 0 ft. to 0 ft.

6 GROUT MATERIAL BENTONITE  
 Grout Intervals: From 5 ft. to 35 ft., From 0 ft. to 0 ft., From 0 ft. to 0 ft.  
 What is the nearest source of possible contamination: SEPTIC TANK  
 Direction from well? SOUTHWEST How many feet? 120

FROM	TO	LITHOLOGIC LOG	FROM	TO	PLUGGING INTERVALS
0	9	SILT AND SAND			
9	48	TAN CLAY			
48	114	SAND AND GRAVEL			
114	118	TAN CLAY			
118	136	SAND AND GRAVEL			
136	140	TAN CLAY			

7 CONTRACTOR'S OR LANDOWNER'S CERTIFICATION: This water well was Constructed under my jurisdiction and was completed on (mo/day/year) 10/10/14 and this record is true to the best of my knowledge and belief. Kansas Water Well Contractor's License No. 653 This Water Well Record was completed on (mo/day/yr) 10/31/14 under the business name of DAN HAYSE WATER WELL SERV by (signature) *Don Hayse*