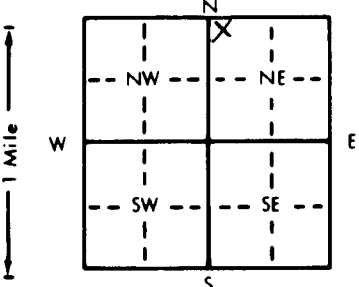


WATER WELL RECORD Form WWC-5 KSA 82a-1212

1 LOCATION OF WATER WELL: Fraction NW 1/4 NW 1/4 NE 1/4 Section Number 16 Township Number T 28 S Range Number R 18 EW

Distance and direction from nearest town or city street address of well if located within city?  
 Triangle lot at Main and California street

2 WATER WELL OWNER: City of Greensburg ks.  
 RR#, St. Address, Box #: 239 S. MAIN Board of Agriculture, Division of Water Resources  
 City, State, ZIP Code: GREENSBURG, KS 67054 Application Number:

3 LOCATE WELL'S LOCATION WITH AN "X" IN SECTION BOX:  

 4 DEPTH OF COMPLETED WELL: 126 ft. ELEVATION:  
 Depth(s) Groundwater Encountered 1. ft. 2. ft. 3. ft.  
 WELL'S STATIC WATER LEVEL: 71' ft. below land surface measured on mo/day/yr 12/27/61  
 Pump test data: Well water was ft. after hours pumping gpm  
 Est. Yield gpm: Well water was ft. after hours pumping gpm  
 Bore Hole Diameter: 3.6 in. to 12.6 ft., and in. to ft.  
 WELL WATER TO BE USED AS:  Public water supply 8 Air conditioning 11 Injection well  
 1 Domestic 3 Feedlot 6 Oil field water supply 9 Dewatering 12 Other (Specify below)  
 2 Irrigation 4 Industrial 7 Lawn and garden only 10 Monitoring well  
 Was a chemical/bacteriological sample submitted to Department? Yes No  If yes, mo/day/yr sample was submitted  
 Water Well Disinfected?  Yes No

5 TYPE OF BLANK CASING USED:  
 Steel 3 RMP (SR) 5 Wrought iron 8 Concrete tile CASING JOINTS: Glued Clamped  
 2 PVC 4 ABS 6 Asbestos-Cement 9 Other (specify below) Welded   
 7 Fiberglass Threaded  
 Blank casing diameter 16 in. to 86 ft. Dia. in. to ft. Dia. in. to ft.  
 Casing height above land surface 36 in., weight lbs./ft. Wall thickness or gauge No.  
 TYPE OF SCREEN OR PERFORATION MATERIAL:  
 1 Steel  Stainless steel 5 Fiberglass 8 RMP (SR) 10 Asbestos-cement  
 2 Brass 4 Galvanized steel 6 Concrete tile 9 ABS 12 None used (open hole)  
 SCREEN OR PERFORATION OPENINGS ARE:  
 1 Continuous slot 3 Mill slot  Wire wrapped 5 Gauzed wrapped 8 Saw cut 11 None (open hole)  
 2 Louvered shutter 4 Key punched 7 Torch cut 9 Drilled holes  
 SCREEN-PERFORATED INTERVALS: From 126 ft. to 86 ft. From ft. to ft.  
 From ft. to ft. From ft. to ft.  
 GRAVEL PACK INTERVALS: From 126 ft. to 75' ft. From ft. to ft.  
 From ft. to ft. From ft. to ft.

6 GROUT MATERIAL:  Neat cement  Cement grout  Bentonite 4 Other  
 Grout Intervals: From 75 ft. to 64 ft. From 64 ft. to 0 ft. From ft. to ft.  
 What is the nearest source of possible contamination:  
 1 Septic tank 4 Lateral lines 7 Pit privy 10 Livestock pens 14 Abandoned water well  
 2 Sewer lines 5 Cess pool 8 Sewage lagoon 11 Fuel storage 15 Oil well/Gas well  
 3 Watertight sewer lines 6 Seepage pit 9 Feedyard 12 Fertilizer storage 16 Other (specify below)  
 13 Insecticide storage  
 Direction from well? How many feet? NONE KNOWN

FROM	TO	LITHOLOGIC LOG	FROM	TO	PLUGGING INTERVALS
0	10	Brown Clay			
10	29.5	Brown clay silty			
29.5	40	Brown to Gray silty clay			
40	55	Brown to Gray Sandy clay			
55	70	Medium to coarse sand to medium gravel			
70	74	Fine Sand			
74	76	Yellow clay soft			
76	100	Coarse sand to medium gravel			
100	110	Medium Sand			
110	120	Medium Sand to medium gravel			
120	135	Tan Clay			

7 CONTRACTOR'S OR LANDOWNER'S CERTIFICATION: This water well was  constructed, (2) reconstructed, or (3) plugged under my jurisdiction and was completed on (mo/day/year) 12-27-01 and this record is true to the best of my knowledge and belief. Kansas Water Well Contractor's License No. 581 This Water Well Record was completed on (mo/day/yr) 12-27-01 under the business name of Layne Western by (signature) Russell W. Reddy

INSTRUCTIONS: Use typewriter or ball point pen. PLEASE PRESS FIRMLY and PRINT clearly. Please fill in blanks, underline or circle the correct answers. Send top three copies to Kansas Department of Health and Environment, Bureau of Water, Topeka, Kansas 66620-0001. Telephone: 913-296-5545. Send one to WATER WELL OWNER and retain one for your records.