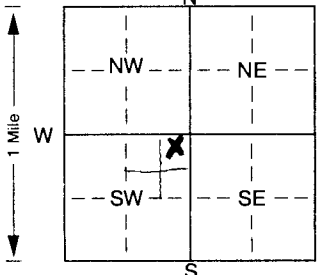


1 LOCATION OF WATER WELL: Fraction SE 1/4 NE 1/4 SW 1/4 Section Number 16 Township Number T 28 Range Number R 18 EAV
 County: KIOWA

Distance and direction from nearest town or city street address of well if located within city?
AT THE CORNER OF Bay St & Hwy 54 & Kansas Ave. Greensburg KS.

2 WATER WELL OWNER: Phillips LG
 RR#, St. Address, Box #: 419 W. Kansas Board of Agriculture, Division of Water Resources
 City, State, ZIP Code: Greensburg KS. 67054 Application Number:

3 LOCATE WELL'S LOCATION WITH AN "X" IN SECTION BOX:

 4 DEPTH OF COMPLETED WELL: 13' ft. ELEVATION:
 Depth(s) Groundwater Encountered 1. 999 ft. 2. ft. 3. ft.
 WELL'S STATIC WATER LEVEL: N/A ft. below land surface measured on mo/day/yr
 Pump test data: Well water was ft. after hours pumping gpm
 Est. Yield gpm Well water was ft. after hours pumping gpm
 Bore Hole Diameter: 8 3/4 in. to 13' ft., and in. to ft.
 WELL WATER TO BE USED AS:
 5 Public water supply 8 Air conditioning 11 Injection well
 1 Domestic 3 Feedlot 6 Oil field water supply 9 Dewatering 12 Other (Specify below)
 2 Irrigation 4 Industrial 7 Domestic (lawn & garden) 10 Monitoring well Cathodic protection
 Was a chemical/bacteriological sample submitted to Department? Yes. No. X ; If yes, mo/day/yr sample was submitted
 Water Well Disinfected? Yes No X

5 TYPE OF BLANK CASING USED:
 1 Steel 3 RMP (SR) 5 Wrought iron 8 Concrete tile CASING JOINTS: Glued. Clamped.
 2 PVC 4 ABS 6 Asbestos-Cement 9 Other (specify below) Welded
 7 Fiberglass NONE Threaded.
 Blank casing diameter N/A in. to ft., Dia in. to ft., Dia in. to ft.
 Casing height above land surface. 0" in., weight lbs./ft. Wall thickness or gauge No.
 TYPE OF SCREEN OR PERFORATION MATERIAL:
 1 Steel 3 Stainless steel 5 Fiberglass 7 PVC 10 Asbestos-cement
 2 Brass 4 Galvanized steel 6 Concrete tile 8 RMP (SR) 11 Other (specify) N/A
 12 None used (open hole)
 SCREEN OR PERFORATION OPENINGS ARE:
 1 Continuous slot 3 Mill slot 5 Gauzed wrapped 8 Saw cut 11 None (open hole)
 2 Louvered shutter 4 Key punched 6 Wire wrapped 9 Drilled holes
 7 Torch cut 10 Other (specify) N/A ft.
 SCREEN-PERFORATED INTERVALS: From ft. to ft., From ft. to ft.
 From N/A ft. to ft., From ft. to ft.
 GRAVEL PACK INTERVALS: From ft. to ft., From ft. to ft.
 From ft. to ft., From ft. to ft.

6 GROUT MATERIAL: 1 Neat cement 2 Cement grout 3 Bentonite 4 Other
 Grout Intervals: From 1 1/2 ft. to 0" ft., From ft. to ft., From ft. to ft.
 What is the nearest source of possible contamination:
 1 Septic tank 4 Lateral lines 7 Pit privy 11 Fuel storage 14 Abandoned water well
 2 Sewer lines 5 Cess pool 8 Sewage lagoon 12 Fertilizer storage 15 Oil well/Gas well
 3 Watertight sewer lines 6 Seepage pit 9 Feedyard 13 Insecticide storage 16 Other (specify below)
 Direction from well? EAST AND WEST How many feet? 3'

FROM	TO	LITHOLOGIC LOG	FROM	TO	PLUGGING INTERVALS
0"	13'	CLAY BROWN MIXED W/SILT	13'	1 1/2'	KOKE BREEZE
			1 1/2'	0"	NEAT CEMENT
<p>NOTE: 3 CATHODIC WELL ANODES WERE DRILLED 15 FT FROM EACH OTHER, THEN THE ANODES WERE PLACED AND KOKE BREEZE AROUND THE ANODES AND CEMENT ON TOP TO SURFACE.</p>					

7 CONTRACTOR'S OR LANDOWNER'S CERTIFICATION: This water well was (1) constructed (2) reconstructed, or (3) plugged under my jurisdiction and was completed on (mo/day/year) 7-20-02 and this record is true to the best of my knowledge and belief. Kansas Water Well Contractor's Licence No. 665 This Water Well Record was completed on (mo/day/yr) 7-25-02 under the business name of Prati Well Environmental by (signature) Steven E. Egan