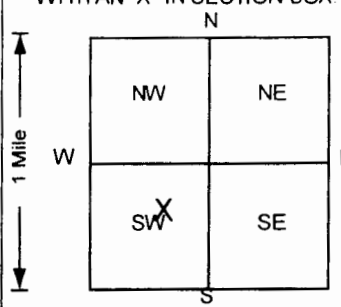


1 LOCATION OF WATER WELL: Fraction **SW 1/4 NE 1/4 SW 1/4** Section Number **16** Township Number **T 28 S** Range Number **R 18 W E 1**
 County: **Kiowa**

Distance and direction from nearest town or city street address of well if located within city?
419 W. Kansas Avenue, Greensburg, Kansas 67054

2 WATER WELL OWNER: **Coastal Mart #2509**
 RR#, St. Address, Box # : **419 W. Kansas** Board of Agriculture, Division of Water Resources
 City, State, ZIP Code : **Greensburg, Kansas 67054** Application Number:

3 LOCATE WELL'S LOCATION WITH AN "X" IN SECTION BOX:


4 DEPTH OF COMPLETED WELL **100** ft. ELEVATION: **0**
 Depth(s) Groundwater Encountered 1. **85.77** ft. 2. **85.77** ft. 3. **85.77** ft.
 WELL'S STATIC WATER LEVEL **85.77** ft. below land surface measured on **mo/day/yr** **12/3/02**
 Pump test data: Well water was **NA** ft. after **NA** hours pumping **NA** gpm
 Est. Yield **NA** gpm: Well water was **NA** ft. after **NA** hours pumping **NA** gpm
 Bore Hole Diameter **12** in. to **100** ft., and **12** in. to **100** ft.
 WELL WATER TO BE USED AS: 5 Public water supply 8 Air conditioning 11 Injection well
 1 Domestic 3 Feedlot 6 Oil field water supply 9 Dewatering 12 Other (Specify below)
 2 Irrigation 4 Industrial 7 Lawn and garden only **10** Monitoring well
 Was a chemical/bacteriological sample submitted to Department? Yes No ; If yes, mo/day/yr sample was submitted
 Water Well Disinfected? Yes No

5 TYPE OF BLANK CASING USED:
 1 Steel 3 RMP (SR) 5 Wrought iron 8 Concrete tile CASING JOINTS: Glued Clamped
2 PVC 4 ABS 6 Asbestos-Cement 9 Other (specify below) Welded
 7 Fiberglass Threaded
 Blank casing diameter **4** in. to **70** ft., Dia **4** in. to **70** ft., Dia **4** in. to **70** ft.
 Casing height above land surface **4** in. weight **4** lbs./ft. Wall thickness or gauge No. **Sch. 40**
 TYPE OF SCREEN OR PERFORATION MATERIAL
 1 Steel 3 Stainless steel 5 Fiberglass **7** PVC 10 Asbestos-cement
 2 Brass 4 Galvanized steel 6 Concrete tile 8 RMP (SR) 11 Other (specify)
 12 None used (open hole)
 SCREEN OR PERFORATION OPENINGS ARE:
 1 Continuous slot **3** Mill slot 5 Gauzed wrapped 8 Saw cut 11 None (open hole)
 2 Louvered shutter 4 Key punched 6 Wire wrapped 9 Drilled holes
 7 Torch cut 10 Other (specify)
 SCREEN-PERFORATED INTERVALS: From **70** ft. to **100** ft., From **70** ft. to **100** ft.
 GRAVEL PACK INTERVALS: From **68** ft. to **100** ft., From **68** ft. to **100** ft.

6 GROUT MATERIAL: **1** Neat cement 2 Cement grout **3** Bentonite 4 Other
 Grout Intervals: From **0** ft. to **65** ft., From **65** ft. to **68** ft., From **68** ft. to **68** ft.
 What is the nearest source of possible contamination:
 1 Septic tank 4 Lateral lines 7 Pit privy **11** Fuel storage 14 Abandoned water well
 2 Sewer lines 5 Cess pool 8 Sewage lagoon 12 Fertilizer storage 15 Oil well/Gas well
 3 Watertight sewer lines 6 Seepage pit 9 Feedyard 13 Insecticide storage 16 Other (specify below)
 Direction from well? **SW** How many feet? **100**

FROM	TO	LITHOLOGIC LOG	FROM	TO	PLUGGING INTERVALS
0	0.5	Asphalt			
0.5	10	Silty Clay, Dark Brown			
10	20	Silty Clay, Brown			
20	25	Silty Sandy Clay, Brown			
25	30	Sandy Clay, Light Brown			
30	35	Sandy Clay, Brown to Light Brown			
35	40	Silty Sand, Brown			
40	60	Sand, Brown			
60	70	Silty Sand, Brown			
70	100	Sand, Light Brown with some Gray/White			
					B-3 Flushmount
					Project Name: Handex - Greensburg
					GeoCore # 1037

7 CONTRACTOR'S OR LANDOWNER'S CERTIFICATION: This water well was **1** constructed, (2) reconstructed, or (3) plugged under my jurisdiction and was completed on (mo/day/year) **11/7/02** and this record is true to the best of my knowledge and belief.
 Kansas Water Well Contractor's License No. **527** This Water Well Record was completed on (mo/day/yr) **12/02/02**
 under the business name of **GeoCore Inc.** by (signature) *[Signature]*