

1 LOCATION OF WATER WELL:
County: Kiowa
Fraction: SW 1/4 NE 1/4 SW 1/4
Section Number: 16
Township Number: T 28 S
Range Number: R 18 W E 1/4


Distance and direction from nearest town or city street address of well if located within city?

419 W. Kansas Avenue, Greensburg, Kansas 67054

2 WATER WELL OWNER: Coastal Mart #2509
RR#, St. Address, Box #: 419 W. Kansas
City, State, ZIP Code: Greensburg, Kansas 67054

Board of Agriculture, Division of Water Resources
Application Number:

3 LOCATE WELL'S LOCATION WITH AN "X" IN SECTION BOX:

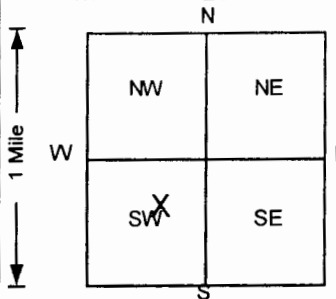

4 DEPTH OF COMPLETED WELL: 20 ft. ELEVATION: 0 ft.
WELL'S STATIC WATER LEVEL: NA ft. below land surface
Pump test data: Well water was NA ft. after ... hours pumping ... gpm
Est. Yield: NA gpm
WELL WATER TO BE USED AS: 12 Other (Specify below) Vapor Extraction w.
Was a chemical/bacteriological sample submitted? No
Water Well Disinfected? No

5 TYPE OF BLANK CASING USED: 2 PVC
Blank casing diameter: 4 in. to 10 ft. Dia
Casing height above land surface: ... lbs./ft. Wall thickness or gauge No. Sch. 40

TYPE OF SCREEN OR PERFORATION MATERIAL: 7 PVC
SCREEN OR PERFORATION OPENINGS ARE: 3 Mill slot

SCREEN-PERFORATED INTERVALS: From 10 ft. to 20 ft.
GRAVEL PACK INTERVALS: From 8 ft. to 20 ft.

6 GROUT MATERIAL: 1 Neat cement
Grout Intervals: From 0 ft. to 6 ft.
Direction from well? SW
How many feet? 100

Table with columns: FROM, TO, LITHOLOGIC LOG, FROM, TO, PLUGGING INTERVALS. Includes lithologic log entries like Concrete, Silty Clay, Sandy Clay.

7 CONTRACTOR'S OR LANDOWNER'S CERTIFICATION: This water well was (1) constructed, (2) reconstructed, or (3) plugged under my jurisdiction and was completed on (mo/day/year) 11/5/02 and this record is true to the best of my knowledge and belief.
Kansas Water Well Contractor's License No. 527 This Water Well Record was completed on (mo/day/yr) 12/02/02
under the business name of GeoCore Inc. by (signature) Dan Bell

INSTRUCTIONS: Use typewriter or ball point pen. PLEASE PRESS FIRMLY and PRINT clearly. Please fill in blanks, underline or circle the correct answers. Send top three copies to Kansas Department of Health and Environment, Bureau of Water, Topeka, Kansas 66620-0001. Telephone: 913-296-5545. Send one to WATER WELL OWNER and retain one for your records.

OFFICE USE ONLY

T

R

EM

SEC

1/4

1/4

1/4