


1 LOCATION OF WATER WELL:	Fraction	Section Number	Township Number	Range Number
County: <u>Kiowa</u>	<u>NE 1/4 SE 1/4 NE 1/4</u>	<u>6</u>	<u>T 28 S</u>	<u>R 18 EW</u>

Distance and direction from nearest town or city street address of well if located within city?  
3.5 miles NW of Greensburg; Kiowa County Landfill

2 WATER WELL OWNER:	RR#, St. Address, Box # :	Board of Agriculture, Division of Water Resources
City, State, ZIP Code :	<u>Kiowa County</u> <u>PO Box 876</u> <u>Greensburg KS 67054</u>	Application Number:

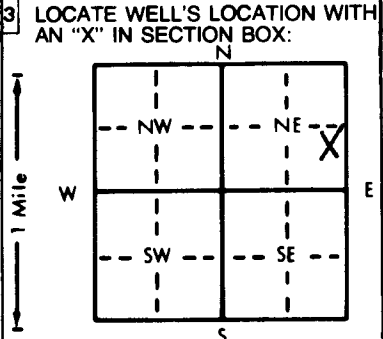

4 DEPTH OF COMPLETED WELL: <u>72</u> ft.	ELEVATION:
Depth(s) Groundwater Encountered 1. <u>61</u> ft. 2. ft. 3. ft.	
WELL'S STATIC WATER LEVEL <u>61.41</u> ft. below land surface measured on mo/day/yr <u>9-1-93</u>	
Pump test data: Well water was ft. after hours pumping gpm	
Est. Yield gpm: Well water was ft. after hours pumping gpm	
Bore Hole Diameter: <u>8</u> in. to ft., and in. to ft.	
WELL WATER TO BE USED AS:	
1 Domestic 3 Feedlot 6 Oil field water supply 9 Dewatering 12 Other (Specify below)	5 Public water supply 8 Air conditioning 11 Injection well
2 Irrigation 4 Industrial 7 Lawn and garden only <u>10 Monitoring well</u>	
Was a chemical/bacteriological sample submitted to Department? Yes No <u>X</u> ; If yes, mo/day/yr sample was submitted	Water Well Disinfected? Yes No <u>X</u>

5 TYPE OF BLANK CASING USED:	5 Wrought iron	8 Concrete tile	CASING JOINTS: Glued Clamped
1 Steel 3 RMP (SR)	6 Asbestos-Cement 9 Other (specify below)	Welded	
<u>2 PVC</u> 4 ABS	7 Fiberglass	<u>Threaded</u> <u>Flush</u>	
Blank casing diameter <u>2</u> in. to ft., Dia in. to ft., Dia in. to ft.			
Casing height above land surface <u>36</u> in., weight <u>703</u> lbs./ft. Wall thickness or gauge No. <u>154</u>			
TYPE OF SCREEN OR PERFORATION MATERIAL:	<u>7 PVC</u>	10 Asbestos-cement	
1 Steel 3 Stainless steel 5 Fiberglass 8 RMP (SR) 11 Other (specify)	2 Brass 4 Galvanized steel 6 Concrete tile 9 ABS 12 None used (open hole)		
SCREEN OR PERFORATION OPENINGS ARE:	5 Gauzed wrapped 8 Saw cut 11 None (open hole)		
1 Continuous slot <u>3 Mill slot</u> 6 Wire wrapped 9 Drilled holes	2 Louvered shutter 4 Key punched 7 Torch cut 10 Other (specify)		
SCREEN-PERFORATED INTERVALS: From <u>52</u> ft. to <u>72</u> ft., From ft. to ft.			
GRAVEL PACK INTERVALS: From <u>51</u> ft. to <u>72</u> ft., From ft. to ft.			

6 GROUT MATERIAL:	1 Neat cement	2 Cement grout	<u>3 Bentonite</u>	4 Other
Grout Intervals: From <u>51</u> ft. to <u>1</u> ft., From ft. to ft., From ft. to ft.				
What is the nearest source of possible contamination:				
1 Septic tank 4 Lateral lines 7 Pit privy 10 Livestock pens 14 Abandoned water well	2 Sewer lines 5 Cess pool 8 Sewage lagoon 11 Fuel storage 15 Oil well/Gas well	3 Watertight sewer lines 6 Seepage pit 9 Feedyard 12 Fertilizer storage 16 Other (specify below)	13 Insecticide storage <u>NA</u>	
Direction from well? <u>NA</u>			How many feet? <u>NA</u>	

FROM	TO	LITHOLOGIC LOG	FROM	TO	PLUGGING INTERVALS
0.0	10.0	Sand, reddish brown			
10.0	13.0	Silty sand, reddish brown			
13.0	18.0	Silty sand, reddish brown, clayey			
18.0	23.0	Sand, reddish brown			
23.0	28.0	Clayey silt, light brown, slightly sandy			
28.0	38.5	Sand, light brown, silty			
38.5	48.0	Silty clay, very sandy			
48.0	72.0	Sand, full of gravel			

7 CONTRACTOR'S OR LANDOWNER'S CERTIFICATION: This water well was <u>(1) constructed</u> (2) reconstructed, or (3) plugged under my jurisdiction and was completed on (mo/day/year) <u>9-1-93</u> and this record is true to the best of my knowledge and belief. Kansas Water Well Contractor's License No. <u>531</u> This Water Well Record was completed on (mo/day/yr) <u>9-15-93</u> under the business name of <u>GSI</u> by (signature) <u>Allison Turner</u>
--

OFFICE USE ONLY  
T  
R  
EW  
SEC  
1/4  
1/4  
1/4