


1 LOCATION OF WATER WELL: County: **Kiowa** Fraction: **SW 1/4 SW 1/4 NW 1/4** Section Number: **7** Township Number: **T 28 S** Range Number: **R 18 E/W**

Distance and direction from nearest town or city street address of well if located within city?
1/2 N 1 W 1/2 N OF HWY 54 & 183 JCT.

2 WATER WELL OWNER: **Eagle Drilling** RR#, St. Address, Box #: **Pratt, Kansas 67124** Board of Agriculture, Division of Water Resources
 City, State, ZIP Code: **Pratt, Kansas 67124** Lease: **Davis 1-7** Application Number: _____

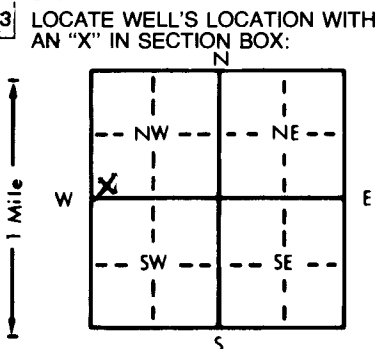

4 DEPTH OF COMPLETED WELL: **100** ft. ELEVATION: _____
 Depth(s) Groundwater Encountered: 1. **78** ft. 2. _____ ft. 3. _____ ft.
 WELL'S STATIC WATER LEVEL: **78** ft. below land surface measured on **mo/day/yr 21 Dec. 83**
 Pump test data: Well water was _____ ft. after _____ hours pumping _____ gpm
 Est. Yield: **80** gpm: Well water was _____ ft. after _____ hours pumping _____ gpm
 Bore Hole Diameter: **10** in. to **100** in. and _____ in. to _____ in.
 WELL WATER TO BE USED AS:
 1 Domestic 3 Feedlot **6** Oil field water supply 8 Air conditioning 11 Injection well
 2 Irrigation 4 Industrial 7 Lawn and garden only 9 Dewatering 12 Other (Specify below)
 Was a chemical/bacteriological sample submitted to Department? Yes _____ No **X** If yes, mo/day/yr sample was submitted _____
 Water Well Disinfected? Yes **X** No _____

5 TYPE OF BLANK CASING USED:
 1 Steel 3 RMP (SR) 5 Wrought iron 8 Concrete tile CASING JOINTS: Glued **X** Clamped _____
2 PVC 4 ABS 6 Asbestos-Cement 9 Other (specify below) Welded _____
 7 Fiberglass Threaded _____
 Blank casing diameter **5** in. to **80** ft., Dia. _____ in. to _____ ft., Dia. _____ in. to _____ ft.
 Casing height above land surface: **12** in., weight: **2.34** lbs./ft. Wall thickness or gauge No. **214**

TYPE OF SCREEN OR PERFORATION MATERIAL:
 1 Steel 3 Stainless steel 5 Fiberglass **7** PVC 10 Asbestos-cement
 2 Brass 4 Galvanized steel 6 Concrete tile 8 RMP (SR) 11 Other (specify) _____
 9 ABS 12 None used (open hole)

SCREEN OR PERFORATION OPENINGS ARE:
 1 Continuous slot 3 Mill slot 5 Gauzed wrapped **8** Saw cut 11 None (open hole)
 2 Louvered shutter 4 Key punched 6 Wire wrapped 9 Drilled holes
 7 Torch cut 10 Other (specify) _____

SCREEN-PERFORATED INTERVALS: From **80** ft. to **100** ft., From _____ ft. to _____ ft.
 From _____ ft. to _____ ft., From _____ ft. to _____ ft.
 GRAVEL PACK INTERVALS: From **10** ft. to **100** ft., From _____ ft. to _____ ft.
 From _____ ft. to _____ ft., From _____ ft. to _____ ft.

6 GROUT MATERIAL: 1 Neat cement **2** Cement grout 3 Bentonite 4 Other _____
 Grout Intervals: From **0** ft. to **10** ft., From _____ ft. to _____ ft., From _____ ft. to _____ ft.

What is the nearest source of possible contamination:
 1 Septic tank 4 Lateral lines 7 Pit privy 10 Livestock pens 14 Abandoned water well
 2 Sewer lines 5 Cess pool 8 Sewage lagoon 11 Fuel storage 15 Oil well/Gas well
 3 Watertight sewer lines 6 Seepage pit 9 Feedyard 12 Fertilizer storage 16 Other (specify below) **NONE**
 13 Insecticide storage

Direction from well? _____ How many feet? _____

FROM	TO	LITHOLOGIC LOG	FROM	TO	LITHOLOGIC LOG
0	2	0 Sandy top soil			
2	23	0 Sand, fine tan and tan silty			
23	30	0 Clay, tan			
30	68	Sand, fine to coarse and fine to med gravel			
68	100	7 Sand, coarse to very coarse gravel			

7 CONTRACTOR'S OR LANDOWNER'S CERTIFICATION: This water well was **1** constructed, (2) reconstructed, or (3) plugged under my jurisdiction and was completed on (mo/day/year) **21 DEC 83** and this record is true to the best of my knowledge and belief. Kansas Water Well Contractor's License No. **325** This Water Well Record was completed on (mo/day/yr) **13 Feb 84** under the business name of **Central Well & Pump Inc.** by (signature) **[Signature]**

INSTRUCTIONS: Use typewriter or ball point pen, PLEASE PRESS FIRMLY and PRINT clearly. Please fill in blanks, underline or circle the correct answers. Send top three copies to Kansas Department of Health and Environment, Division of Environment, Environmental Geology Section, Topeka, KS 66620. Send one to WATER WELL OWNER and retain one for your records.

OFFICE USE ONLY
T 28 R 18 E/W
SEC. 7
SW 1/4
SW 1/4
NW 1/4