


1 LOCATION OF WATER WELL: County: kiowa Fraction: SE 1/4 SE 1/4 SE 1/4 Section Number: 8 Township Number: T 28 S Range Number: R 18 EW

Distance and direction from nearest town or city street address of well if located within city?  
1/2 E N. Side of GREENSBURG Kans

2 WATER WELL OWNER: Dale ROSENBERGER  
 RR#, St. Address, Box #: Greensburg Kans  
 City, State, ZIP Code: Greensburg Kans  
 Board of Agriculture, Division of Water Resources Application Number:

3 LOCATE WELL'S LOCATION WITH AN "X" IN SECTION BOX:

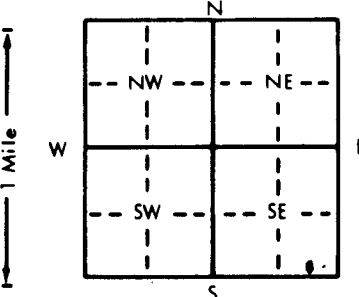

4 DEPTH OF COMPLETED WELL: 118 ft. ELEVATION:  
 Depth(s) Groundwater Encountered 1. 66 ft. 2. 66 ft. 3. 66 ft.  
 WELL'S STATIC WATER LEVEL: 66 ft. below land surface measured on 3-15-83  
 Pump test data: Well water was 66 ft. after 1 hours pumping 10 gpm  
 Est. Yield 25 gpm: Well water was 66 ft. after 10 hours pumping 10 gpm  
 Bore Hole Diameter: 8 3/4 in. to 11 8 ft. and 11 8 in. to 11 8 ft.  
 WELL WATER TO BE USED AS:  
 Domestic 3 Feedlot 6 Oil field water supply 9 Dewatering 12 Other (Specify below)  
 2 Irrigation 4 Industrial 7 Lawn and garden only 10 Observation well  
 Was a chemical/bacteriological sample submitted to Department? Yes     No X; If yes, mo/day/yr sample was submitted      
 Water Well Disinfected? Yes X No    

5 TYPE OF CASING USED:  
 1 Steel 2 PVC 3  RMP (SR) 4 ABS  
 5 Wrought iron 6 Asbestos-Cement 7 Fiberglass  
 8 Concrete tile 9 Other (specify below)  
 CASING JOINTS: Glued X Clamped      
 Welded     Threaded    

Blank casing diameter: 5 in. to 100 ft., Dia.     in. to     ft., Dia.     in. to     ft.  
 Casing height above land surface: 12 in., weight     lbs./ft. Wall thickness or gauge No. SDR-26

TYPE OF SCREEN OR PERFORATION MATERIAL:  
 1 Steel 2 Brass 3 Stainless steel 4 Galvanized steel 5 Fiberglass 6 Concrete tile 7 PVC 8  RMP (SR) 9 ABS 10 Asbestos-cement 11 Other (specify) 12 None used (open hole)

SCREEN OR PERFORATION OPENINGS ARE:  
 1 Continuous slot 2 Louvered shutter 3 Mill slot 4 Key punched 5 Gauzed wrapped 6 Wire wrapped 7 Torch cut 8  Saw cut 9 Drilled holes 11 None (open hole) 10 Other (specify)

SCREEN-PERFORATED INTERVALS: From 10.0 ft. to 118 ft., From     ft. to     ft., From     ft. to     ft.  
 GRAVEL PACK INTERVALS: From 85 ft. to 118 ft., From     ft. to     ft., From     ft. to     ft.

6 GROUT MATERIAL:  Neat cement 2 Cement grout 3 Bentonite 4 Other  
 Grout Intervals: From 4 ft. to 15 ft., From     ft. to     ft., From     ft. to     ft.

What is the nearest source of possible contamination:  
 Septic tank 4 Lateral lines 7 Pit privy 10 Livestock pens 14 Abandoned water well  
 2 Sewer lines 5 Cess pool 8 Sewage lagoon 11 Fuel storage 15 Oil well/Gas well  
 3 Watertight sewer lines 6 Seepage pit 9 Feedyard 12 Fertilizer storage 16 Other (specify below)  
 13 Insecticide storage  
 Direction from well? N How many feet? 60

FROM	TO	LITHOLOGIC LOG	FROM	TO	LITHOLOGIC LOG
0	2	TOP SOIL			
2	17	BROWN clay			
17	20	Sand			
20	63	Tan Clay			
63	118	GRAVEL			

7 CONTRACTOR'S OR LANDOWNER'S CERTIFICATION: This water well was  constructed, (2) reconstructed, or (3) plugged under my jurisdiction and was completed on (mo/day/year) 3-15-83 and this record is true to the best of my knowledge and belief. Kansas Water Well Contractor's License No. 224 This Water Well Record was completed on (mo/day/yr) 7-23-83 under the business name of Carl Kayse Water Well Sew. by (signature) Carl Kayse  
 INSTRUCTIONS: Use typewriter or ball point pen, PLEASE PRESS FIRMLY and PRINT clearly. Please fill in blanks, underline or circle the correct answers. Send top three copies to Kansas Department of Health and Environment, Division of Environment, Environmental Geology Section, Topeka, KS 66620. Send one to WATER WELL OWNER and retain one for your records.

OFFICE USE ONLY  
T  
R  
18  
SEC. 8  
SE 1/4  
SE 1/4  
SE 1/4  
SE 1/4