


1 LOCATION OF WATER WELL: County: **Kiowa** Fraction: **SW₄ NE 1/4 SE 1/4** Section Number: **16** Township Number: **T 28 S** Range Number: **R 18 E** **(EW)**

Distance and direction from nearest town or city street address of well if located within city?
150' West of Pine Street

2 WATER WELL OWNER: **James Jackson - Volz Oil**
 RR#, St. Address, Box #: **222 East Kansas**
 City, State, ZIP Code: **Greensburg, Ks.**
 Board of Agriculture, Division of Water Resources
 Application Number:

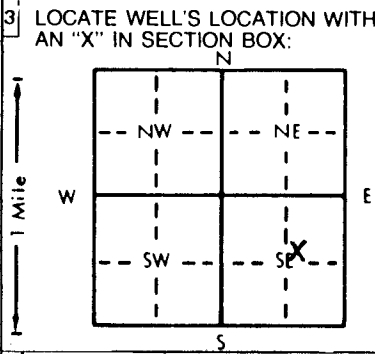

4 DEPTH OF COMPLETED WELL: **85** ft. ELEVATION: **NA**
 Depth(s) Groundwater Encountered: 1. **75** ft. 2. ft. 3. ft.
 WELL'S STATIC WATER LEVEL: **75.33** ft. below land surface measured on mo/day/yr **03-04-94**
 Pump test data: Well water was ft. after hours pumping gpm
 Est. Yield gpm: Well water was ft. after hours pumping gpm
 Bore Hole Diameter: **7.5/8** in. to **85** ft., and in. to ft.
 WELL WATER TO BE USED AS:
 5 Public water supply 8 Air conditioning 11 Injection well
 1 Domestic 3 Feedlot 6 Oil field water supply 9 Dewatering 12 Other (Specify below)
 2 Irrigation 4 Industrial 7 Lawn and garden only **(10) Monitoring well**
 Was a chemical/bacteriological sample submitted to Department? Yes No **X**; If yes, mo/day/yr sample was submitted
 Water Well Disinfected? Yes No **X**

5 TYPE OF BLANK CASING USED:
 1 Steel 3 RMP (SR) 5 Wrought iron 8 Concrete tile CASING JOINTS: Glued Clamped
(2) PVC 4 ABS 6 Asbestos-Cement 9 Other (specify below) Welded
 7 Fiberglass Threaded **X**
 Blank casing diameter: **2** in. to **60** ft., Dia in. to ft., Dia in. to ft.
 Casing height above land surface: **0** in., weight lbs./ft. Wall thickness or gauge No. **sch. 40**
 TYPE OF SCREEN OR PERFORATION MATERIAL:
 1 Steel 3 Stainless steel 5 Fiberglass **(7) PVC** 10 Asbestos-cement
 2 Brass 4 Galvanized steel 6 Concrete tile 8 RMP (SR) 11 Other (specify)
 9 ABS 12 None used (open hole)
 SCREEN OR PERFORATION OPENINGS ARE:
 1 Continuous slot **(3) Mill slot** 5 Gauzed wrapped 8 Saw cut 11 None (open hole)
 2 Louvered shutter 4 Key punched 6 Wire wrapped 9 Drilled holes
 7 Torch cut 10 Other (specify)
 SCREEN-PERFORATED INTERVALS: From **60** ft. to **85** ft., From ft. to ft.
 GRAVEL PACK INTERVALS: From **58** ft. to **85** ft., From ft. to ft.

6 GROUT MATERIAL: 1 Neat cement **(2) Cement grout** **(3) Bentonite** 4 Other
 Grout Intervals: From **0** ft. to **54** ft., From **54** ft. to **58** ft., From ft. to ft.
 What is the nearest source of possible contamination:
 1 Septic tank 4 Lateral lines 7 Pit privy **(11) Fuel storage** 14 Abandoned water well
 2 Sewer lines 5 Cess pool 8 Sewage lagoon 12 Fertilizer storage 15 Oil well/Gas well
 3 Watertight sewer lines 6 Seepage pit 9 Feedyard 13 Insecticide storage 16 Other (specify below)
 Direction from well? **northwest** How many feet? **365**

FROM	TO	LITHOLOGIC LOG	FROM	TO	PLUGGING INTERVALS
0	6'	cl, v dk brn, organic rich in top 2", sl-mod slty			
6	12	cl, lt brn, v slty			
12	20	cl, lt red brn, v slty, tr v f snd & calc mat			
20	35	snd, lt red brn, v f-med grnd, v slty, sl-mod cly			
35	41	cl, lt red brn, v slty, mod-v sndy, f-med grnd			
41	60	snd, v f-med grnd, v slty, sl-mod cly, lt-red brn in cl			
60	70	snd, f-c, sl grvl, v slty, lt-med yell brn			
70	85	snd, f-med, sl-mod c grns & med grvl & rock up to 1" in size			
					MW9-flush mount cover

7 CONTRACTOR'S OR LANDOWNER'S CERTIFICATION: This water well was **(1)** constructed, (2) reconstructed, or (3) plugged under my jurisdiction and was completed on (mo/day/year) **02-22-94** and this record is true to the best of my knowledge and belief. Kansas Water Well Contractor's License No. **527** This Water Well Record was completed on (mo/day/yr) **04-04-94** under the business name of **GeoCore Services, Inc.** by (signature) *Dale Bell*

INSTRUCTIONS: Use typewriter or ball point pen. PLEASE PRESS FIRMLY and PRINT clearly. Please fill in blanks, underline or circle the correct answers. Send top three copies to Kansas Department of Health and Environment, Bureau of Water, Topeka, Kansas 66620-0001. Telephone: 913-296-5545. Send one to WATER WELL OWNER and retain one for your records.