


1 LOCATION OF WATER WELL: County: **Kiowa** Fraction: **SE 1/4 NW 1/4 SE 1/4** Section Number: **16** Township Number: **T 28 S** Range Number: **18 E** **EW**

Distance and direction from nearest town or city street address of well if located within city?

NE corner of Pine Street and East Kansas Avenue

2 WATER WELL OWNER: **James Jackson - Volz Oil**
 RR#, St. Address, Box #: **222 East Kansas**
 City, State, ZIP Code: **Greensburg, Ks.**
 Board of Agriculture, Division of Water Resources
 Application Number: **03-04-94**

3 LOCATE WELL'S LOCATION WITH AN "X" IN SECTION BOX:

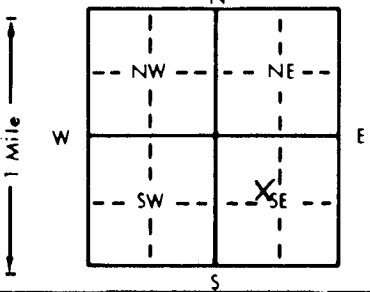

4 DEPTH OF COMPLETED WELL: **85** ft. ELEVATION: **NA**
 Depth(s) Groundwater Encountered 1. **72** ft. 2. ft. 3. ft.
 WELL'S STATIC WATER LEVEL: **71.18** ft. below land surface measured on mo/day/yr **03-04-94**
 Pump test data: Well water was ft. after hours pumping gpm
 Est. Yield gpm: Well water was ft. after hours pumping gpm
 Bore Hole Diameter: **7 5/8** in. to **85** ft., and in. to ft.
 WELL WATER TO BE USED AS:
 5 Public water supply 8 Air conditioning 11 Injection well
 1 Domestic 3 Feedlot 6 Oil field water supply 9 Dewatering 12 Other (Specify below)
 2 Irrigation 4 Industrial 7 Lawn and garden only **10** Monitoring well
 Was a chemical/bacteriological sample submitted to Department? Yes No **X**; If yes, mo/day/yr sample was submitted
 Water Well Disinfected? Yes No **X**

5 TYPE OF BLANK CASING USED:
 1 Steel 3 RMP (SR) 5 Wrought iron 8 Concrete tile CASING JOINTS: Glued Clamped
2 PVC 4 ABS 6 Asbestos-Cement 9 Other (specify below) Welded
 7 Fiberglass Threaded **X**
 Blank casing diameter: **2** in. to **60** ft., Dia. in. to ft., Dia. in. to ft.
 Casing height above land surface: **0** in., weight lbs./ft. Wall thickness or gauge No. **sch. 40**
 TYPE OF SCREEN OR PERFORATION MATERIAL:
 1 Steel 3 Stainless steel 5 Fiberglass **7** PVC 10 Asbestos-cement
 2 Brass 4 Galvanized steel 6 Concrete tile 8 RMP (SR) 11 Other (specify)
 12 None used (open hole)
 SCREEN OR PERFORATION OPENINGS ARE:
 1 Continuous slot **3** Mill slot 5 Gauzed wrapped 8 Saw cut 11 None (open hole)
 2 Louvered shutter 4 Key punched 6 Wire wrapped 9 Drilled holes
 7 Torch cut 10 Other (specify)
 SCREEN-PERFORATED INTERVALS: From **60** ft. to **85** ft., From ft. to ft.
 From ft. to ft., From ft. to ft.
 GRAVEL PACK INTERVALS: From **58** ft. to **85** ft., From ft. to ft.
 From ft. to ft., From ft. to ft.

6 GROUT MATERIAL: 1 Neat cement **2** Cement grout **3** Bentonite 4 Other
 Grout Intervals: From **0** ft. to **54** ft., From **54** ft. to **58** ft., From ft. to ft.
 What is the nearest source of possible contamination:
 1 Septic tank 4 Lateral lines 7 Pit privy **11** Fuel storage 10 Livestock pens 14 Abandoned water well
 2 Sewer lines 5 Cess pool 8 Sewage lagoon 12 Fertilizer storage 15 Oil well/Gas well
 3 Watertight sewer lines 6 Seepage pit 9 Feedyard 13 Insecticide storage 16 Other (specify below)
 Direction from well? **southwest** How many feet? **130**

FROM	TO	LITHOLOGIC LOG	FROM	TO	PLUGGING INTERVALS
0	1.5	cly, med brn, mod slty, org rich, tr f-c snd	60	70	snd, rst orang-brn, v slty, f-c grnd,
1.5	6.5	cly, v slty, med red brn, damp-dry			sl grvl, prly srtf
6.5	15	slt, lt-oran-brn, sl clyey, sl f-med grn snd	70	83	snd, lt brn-gry, v slty, sl-mod cly, v f-
15	25	slt, med brn-orang, tr v f snd, damp-dry			med grnd
25	30	slt, lt-med brn-orang, sl clyey, mod v f-f grnd snd, sl blk carb mat	83	85	cly, lt red-brn, v slty, sl-mod snd, v f grnd
30	35	cly, v slty, tr-sl snd, v f-f grnd, mod-lt brn in color			
35	42	snd, lt orang-brn, v slty, sl clyey, v f-med grnd			
42	52	cly, med brn, v slty, mod-v sndy, v f-c			
52	60	snd, yell-brn, sl rst clr, f-c grnd, tr of grvl, prly srtf, sl odor, v slty, v sl cly			
					MW5-flush mount cover

7 CONTRACTOR'S OR LANDOWNER'S CERTIFICATION: This water well was **1** constructed, (2) reconstructed, or (3) plugged (under my jurisdiction and was completed on (mo/day/year) **01-20-94** and this record is true to the best of my knowledge and belief. Kansas Water Well Contractor's License No. **527**. This Water Well Record was completed on (mo/day/yr) **04-04-94** under the business name of **GebCore Services, Inc.** by (signature) *Paul Robb*

INSTRUCTIONS: Use typewriter or ball point pen. PLEASE PRESS FIRMLY and PRINT clearly. Please fill in blanks, underline or circle the correct answers. Send top three copies to Kansas Department of Health and Environment, Bureau of Water, Topeka, Kansas 66620-0001. Telephone: 913-296-5545. Send one to WATER WELL OWNER and retain one for your records.