


1 LOCATION OF WATER WELL: County: **KIOWA** Fraction: **SE 1/4 NW 1/4 SE 1/4** Section Number: **16** Township Number: **T 28 S** Range Number: **R 18 EW**

Distance and direction from nearest town or city street address of well if located within city?
116' 9" EAST of MAIN 33' 4" SOUTH of US 54 HWY CENTER LINE

2 WATER WELL OWNER: **FARMERS CHAIN & SUPPLY**
 RR#, St. Address, Box #: **102 E KANSAS**
 City, State, ZIP Code: **GREENSBURG, KS**
 Board of Agriculture, Division of Water Resources
 Application Number:

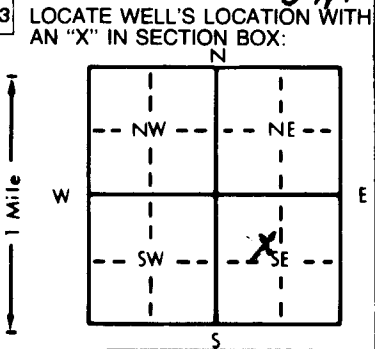

4 DEPTH OF COMPLETED WELL: **95.0** ft. ELEVATION:
 Depth(s) Groundwater Encountered: 1. **82.0** ft. 2. ft. 3. ft.
 WELL'S STATIC WATER LEVEL: **78.92** ft. below land surface measured on mo/day/yr **1/18/94**
 Pump test data: Well water was ft. after hours pumping gpm
 Est. Yield gpm: Well water was ft. after hours pumping gpm
 Bore Hole Diameter: **7 5/8** in. to **95.0** ft., and in. to ft.
 WELL WATER TO BE USED AS:
 5 Public water supply 8 Air conditioning 11 Injection well
 1 Domestic 3 Feedlot 6 Oil field water supply 9 Dewatering 12 Other (Specify below)
 2 Irrigation 4 Industrial 7 Lawn and garden only Monitoring well **M.W. 7**
 Was a chemical/bacteriological sample submitted to Department? Yes No ; If yes, mo/day/yr sample was submitted
 Water Well Disinfected? Yes No

5 TYPE OF BLANK CASING USED:
 1 Steel 3 RMP (SR) 5 Wrought iron 8 Concrete tile CASING JOINTS: Glued Clamped
 2 PVC 4 ABS 6 Asbestos-Cement 9 Other (specify below) Welded
 7 Fiberglass Threaded
 Blank casing diameter: **2** in. to **67.0** ft., Dia. in. to ft., Dia. in. to ft.
 Casing height above land surface: **-7** in., weight lbs./ft. Wall thickness or gauge No. **Sched 40**
 TYPE OF SCREEN OR PERFORATION MATERIAL:
 1 Steel 3 Stainless steel 5 Fiberglass 8 RMP (SR) 10 Asbestos-cement
 2 Brass 4 Galvanized steel 6 Concrete tile 9 ABS 11 Other (specify)
 12 None used (open hole)
 SCREEN OR PERFORATION OPENINGS ARE:
 1 Continuous slot 3 Mill slot 5 Gauzed wrapped 8 Saw cut 11 None (open hole)
 2 Louvered shutter 4 Key punched 6 Wire wrapped 9 Drilled holes
 7 Torch cut 10 Other (specify)
 SCREEN-PERFORATED INTERVALS: From **67.0** ft. to **92.0** ft., From ft. to ft.
 From ft. to ft., From ft. to ft.
 GRAVEL PACK INTERVALS: From **62.1** ft. to **95.0** ft., From ft. to ft.
 From ft. to ft., From ft. to ft.

6 GROUT MATERIAL: 1 Neat cement 2 Cement grout 3 Bentonite 4 Other
 Grout Intervals: From **1.0** ft. to **56.7** ft., From ft. to ft., From ft. to ft.
 What is the nearest source of possible contamination:
 1 Septic tank 4 Lateral lines 7 Pit privy 10 Livestock pens 14 Abandoned water well
 2 Sewer lines 5 Cess pool 8 Sewage lagoon 11 Fuel storage 15 Oil well/Gas well
 3 Watertight sewer lines 6 Seepage pit 9 Feedyard 12 Fertilizer storage 16 Other (specify below)
 13 Insecticide storage
 Direction from well? How many feet?

FROM	TO	LITHOLOGIC LOG	FROM	TO	PLUGGING INTERVALS
0	4"	CONCRETE			
4"	8"	CLAY, BROWN, some silt			
8"	18'	SILT, Red-Brown, Clayey			
18'	25'	SILT, Red-Brown, increased clay, Caliche			
25'	44'	SILT, Red Brown, Less clay, Caliche			
44'	50'	SILT, Brown, Clayey, Caliche			
50'	58'	SILT, Brown, Clayey			
58'	61'	SILT, Brown, FINE SAND			
61'	65'	SILT, TAN, Clayey			
65'	75'	SILT, Brown, SANDY, with pebbles to 3/4"			
75'	95'	SAND, Brown, FINE to coarse, with pebbles			

7 CONTRACTOR'S OR LANDOWNER'S CERTIFICATION: This water well was (1) constructed, (2) reconstructed, or (3) plugged under my jurisdiction and was completed on (mo/day/year) **1/15/94** and this record is true to the best of my knowledge and belief. Kansas Water Well Contractor's License No. **483** This Water Well Record was completed on (mo/day/yr) **4/28/94** under the business name of **TEST** by (signature) *Clay E. Wye*

OFFICE USE ONLY
T
R
EW
SEC.