


1 LOCATION OF WATER WELL: County: <u>Kiowa</u>	Fraction <u>NE 1/4 NW 1/4 SW 1/4</u>	Section Number <u>24</u>	Township Number <u>T 28 S</u>	Range Number <u>R 18W EW</u>
---	---	-----------------------------	----------------------------------	---------------------------------

Distance and direction from nearest town or city street address of well if located within city?
1 S, 2 W of Brenham, Kansas

2 WATER WELL OWNER: <u>Byrd Hardy</u> RR#, St. Address, Box # : <u>209 E Grant</u> City, State, ZIP Code : <u>Greensburg, Ks. 67054</u>	<u>Advantage Resources, Inc.</u> <u>1775 Sherman, #1375</u> <u>Denver, Colorado 80203</u>	<u>Byrd Hardy</u> Board of Agriculture, Division of Water Resources Application Number: <u>930469</u>
---	---	---

3 LOCATE WELL'S LOCATION WITH AN "X" IN SECTION BOX:

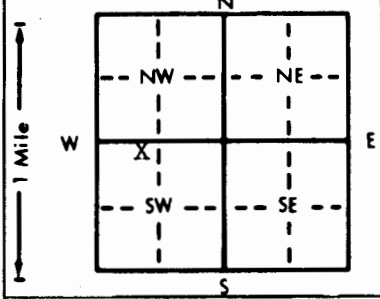

4 DEPTH OF COMPLETED WELL: <u>155</u> ft. ELEVATION: <u>Unknown</u>
Depth(s) Groundwater Encountered: 1. <u>100</u> ft. 2. _____ ft. 3. _____ ft.
WELL'S STATIC WATER LEVEL: <u>100</u> ft. below land surface measured on <u>11/26/93</u> mo/day/yr
Pump test data: Well water was _____ ft. after _____ hours pumping _____ gpm
Est. Yield: <u>60</u> gpm: Well water was _____ ft. after _____ hours pumping _____ gpm
Bore Hole Diameter: <u>8</u> in. to <u>155</u> ft., and _____ in. to _____ ft.
WELL WATER TO BE USED AS: 1 Domestic 2 Irrigation 3 Feedlot 4 Industrial 5 Public water supply 6 <u>Oil field water supply</u> 7 Lawn and garden only 8 Air conditioning 9 Dewatering 10 Monitoring well 11 Injection well 12 Other (Specify below)
Was a chemical/bacteriological sample submitted to Department? Yes _____ No <u>_____</u> ; If yes, mo/day/yr sample was submitted _____
Water Well Disinfected? Yes _____ No <u>_____</u>

5 TYPE OF BLANK CASING USED: 1 Steel 2 <u>PVC</u> 3 RMP (SR) 4 ABS 5 Wrought iron 6 Asbestos-Cement 7 Fiberglass	8 Concrete tile 9 Other (specify below)	CASING JOINTS: <u>Glued</u> _____ Clamped _____ Welded _____ Threaded _____
Blank casing diameter: <u>5</u> in. to <u>135</u> ft. Dia	_____ in. to _____ ft. Dia	_____ in. to _____ ft. Dia
Casing height above land surface: <u>12</u> in. weight: <u>2.8</u> lbs./ft. Wall thickness or gauge No. <u>Sch. 40</u>		
TYPE OF SCREEN OR PERFORATION MATERIAL: 1 Steel 2 Brass 3 Stainless steel 4 Galvanized steel 5 Fiberglass 6 Concrete tile 7 <u>PVC</u> 8 RMP (SR) 9 ABS 10 Asbestos-cement 11 Other (specify) 12 None used (open hole)		
SCREEN OR PERFORATION OPENINGS ARE: 1 Continuous slot 2 Louvered shutter 3 Mill slot 4 Key punched 5 Gauzed wrapped 6 Wire wrapped 7 Torch cut 8 <u>Saw cut</u> 9 Drilled holes 10 Other (specify) 11 None (open hole)		
SCREEN-PERFORATED INTERVALS: From _____ ft. to <u>135</u> ft. to <u>155</u> ft. From _____ ft. to _____ ft. From _____ ft. to _____ ft.		
GRAVEL PACK INTERVALS: From _____ ft. to <u>20</u> ft. to <u>155</u> ft. From _____ ft. to _____ ft. From _____ ft. to _____ ft.		

6 GROUT MATERIAL: 1 Neat cement 2 Cement grout 3 <u>Bentonite</u> 4 Other
Grout Intervals: From <u>0</u> ft. to <u>20</u> ft. From _____ ft. to _____ ft. From _____ ft. to _____ ft.
What is the nearest source of possible contamination: 1 Septic tank 2 Sewer lines 3 Watertight sewer lines 4 Lateral lines 5 Cess pool 6 Seepage pit 7 Pit privy 8 Sewage lagoon 9 Feedyard 10 Livestock pens 11 Fuel storage 12 Fertilizer storage 13 Insecticide storage 14 Abandoned water well 15 <u>Oil well/Gas well</u> 16 Other (specify below)
Direction from well? <u>South</u> How many feet? <u>60</u>

FROM	TO	LITHOLOGIC LOG	FROM	TO	PLUGGING INTERVALS
0	65	Clay			
65	155	Sand and gravel			

7 CONTRACTOR'S OR LANDOWNER'S CERTIFICATION: This water well was (1) constructed, (2) reconstructed, or (3) plugged under my jurisdiction and was completed on (mo/day/year) 11/26/93 and this record is true to the best of my knowledge and belief. Kansas Water Well Contractor's License No. 186 This Water Well Record was completed on (mo/day/yr) 12/8/93 under the business name of Kelly's Water Well Service, Inc. by (signature) [Signature]

OFFICE USE ONLY T R EW SEC.